


Section 16 Township 10 Range 20-W

Well No. #1 Shaw

Company Heathman Drlg.

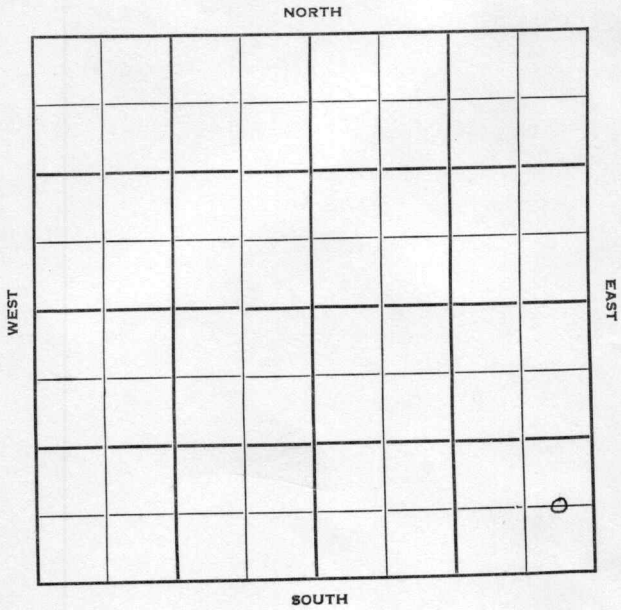

Sec. 16 Twp. Rooks 10 R. KANSAS 20W

Well No. #1 Shaw Farm

Heathman Drlg. Company

Contractor

Marcotte


Ft. from N. Line

660' Ft. from S. Line

330' Ft. from E. Line

Ft. from W. Line

E/2 SE SE

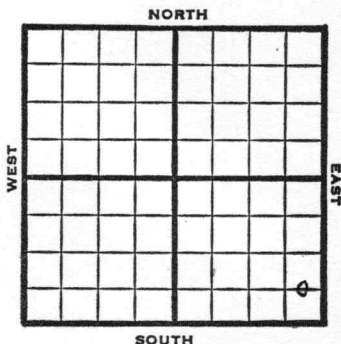

1950

Elev. 2183' REPORT

5/24

Spud 5-21-50

8" @ 132'

WOC

6/7

8" @ 132'

Topeka 3220'

Lans. 3470'

BKC 3698'

Cong 3732'

TD 3839 in Cong.

D&A

ABANDONED


Kansas

Map No. _____ Sec. 16 Twp. 10 R. 20WWell No. 1 ShawHeathman Drlg. Company

Contractor

E/2 SE SE

SECTION PLAT

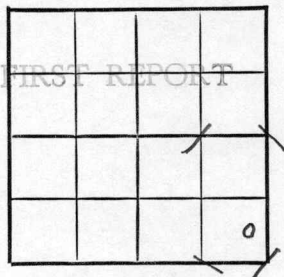

FIRST REPORT

_____ Ft. from N. Line

660 Ft. from S. Line330 Ft. from E. Line

_____ Ft. from W. Line

Rocks

Location _____

Rig up _____

Drilling and Remarks:

Spud 5-21-50

8" @ 132

W.O. C.

RECORD

Cased _____ in., _____ ft.

Sand _____

Gas _____

Oil _____

Total Depth _____

PRODUCTION

1st 24 hrs. Nat. _____

1st 24 hrs. after shot _____

Gas _____ Cu. Ft.

Dry Hole _____

Abandoned _____

Date

MAY 24 1950

J. E. TYRA Scout

Kansas Marcotte

Map No. 10 Sec. 16 Twp. 10 R. 20WWell No. 1 ShawHeathman Drlg. CompanyC E/2 SE SE Contractor E1.2183

SECTION PLAT

 Ft. from N. Line660 Ft. from S. Line330 Ft. from E. Line Ft. from W. Line

Rocks

Location

Rig up

Drilling and Remarks:

8" @ 132
 Topoka 3220
 Lams 3470
 BXC 3698
 Cong 3732
 T.D. 3839 in Cong

D & A

Date

RECORD

Cased in., ft.Sand Gas Oil Total Depth

PRODUCTION

1st 24 hrs. Nat. 1st 24 hrs. after shot Gas Cu. Ft.Dry Hole Abandoned JUN 7 1950 19J. E. TYRA Scout