
FORM 51 25M 8-50 WESTERN Graham KANSAS

Section 16 Township 10 Range 21 W

Well No. # 1 Noah (E)

Company Jones, Shelburne & Famer

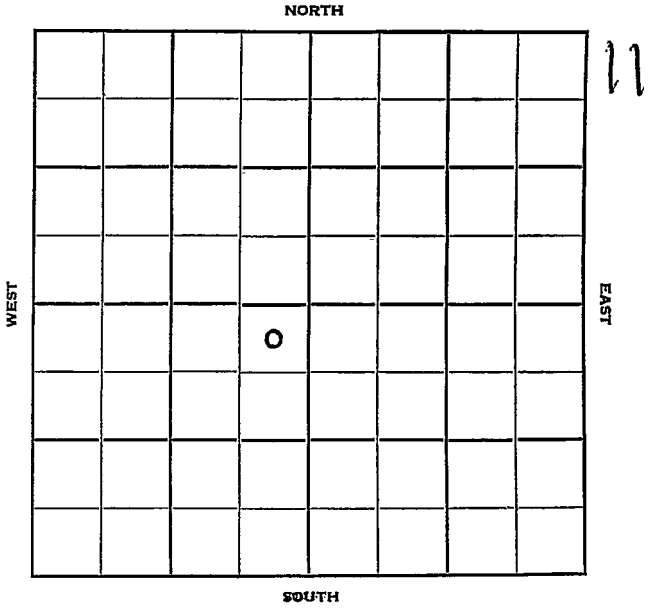

FORM 252-B
10M 8-51 TPCO.

Graham

KANSAS

Sec. 16 Twp. 10 R. 21W

Well No. #1 Noah (E) Farm

Jones, Shelburne & Farmer Company

Contractor

Wildcat


330' Ft. from N. Line

Ft. from S. Line

330' Ft. from E. Line

Ft. from W. Line

NE NE SW

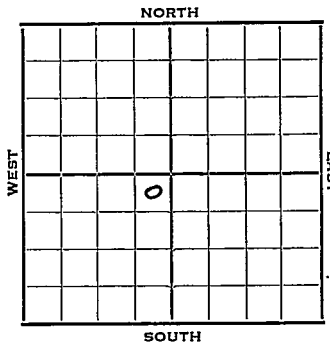

1952	Elev. 2170' REPORT
3/12	Spud 3-7-52 Drlg. 1000'
3/19 4/2	NR Spud 3-7-52 D&A TD 3815 Tor. 3420 Lans. 3439 BKC 3666 Arb. 3775 DST 3778-3815 opn 20 min. Rec. 2200' sw TD 3815 D&A

ABANDONED

3815
2170
1645

FORM 275 FOR SALE BY KANSAS BLUE PRINT CO.


County Graham State Kansas

Sec. 16 (Blk. / Twp.) 10 (Sur. / Rge.) 21W Map No.

Operator Jones, Shelburne & Farmer

Well No. 1 Farm Noah (E)

Elev. Location NE NE SW

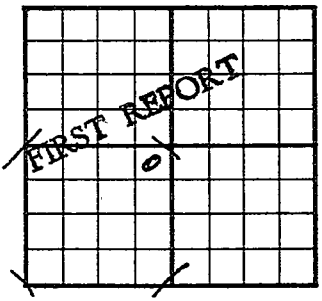

330 Ft. From N Line SW

330 Ft. From E Line Quarter

1st. Report MAR 1 2 1952

Completion

Remarks

Spudding Date 3-7-52

Drlg. Data Wildcat

Drlg. 1000

J. G. McGEHEE

FORM 275 FOR SALE BY KANSAS BLUE PRINT CO.


County Graham State Kansas

Sec. 16 (Blk. Twp.) 10 (Sur. Rge.) 21W Map No.

Operator Jones, Shelburne & Farmer

Well No. 1 Farm Noah "E"

Elev. 2170 Location NE NE SW

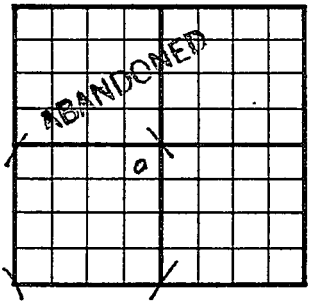

330 Ft. From N Line SW

330 Ft. From E Line Quarter

1st. Report

Completion APR 2 1952

Remarks Wildcat

Spudding Date 3-7-52

Drlg. Data D & A TD 3815

Tor. 3420 Lans. 3439 B KC 3666

Arb. 3775 DST 3778-3815 open 20 min.

Rec. 2200' sw TD 3815

D & A

J. G. McGEHEE