Graham


DX 78-1

KANSAS

Section 16 Township 10 Range 23W

Well No. #1 Stewart.

Company Birmingham & Bartlett.

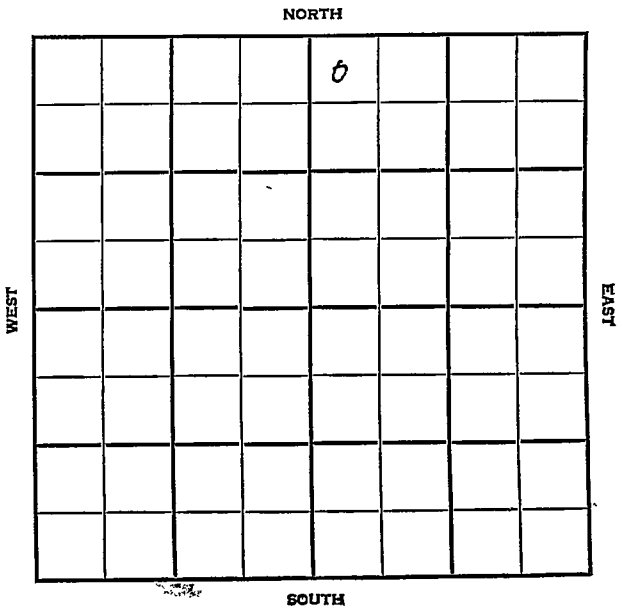

Graham KANSAS

SEC.	TWP.	R.
16	10	23W

WELL NO. #1 Stewart. FARM

COMPANY Birmingham & Bartlett

CONTRACTOR Co. Tools. ~~Hoof Pool~~


330 Ft. from N. Line

_____ Ft. from S. Line

_____ Ft. from E. Line

330 Ft. from W. Line

NW NW NE

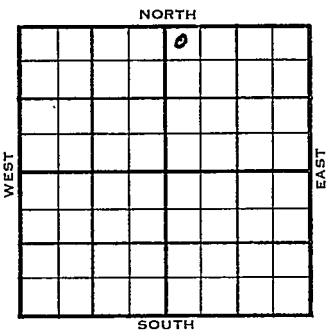

1955 ELEVATION 2415' REPORT

2/23
3/23

Location
Spud 2-24-55, Oil Well, TD 3940
8" @ 245, Anhy 1959, Heeb 3651,
Tor 3671, Lans 3683, DST 3861-
69 open 1 hr, gas in 27 min.
Rec 1380' oil 680#, DST 3879-86
open 25 min. Rec 50' mud 0#
TD 3940 5" @ 3940 CO to 3907
24/3864-70, FU 1400' oil, 1 hr
1000" S/10 BOPH 4 hr SP 3858,
24/3846-54, FU 2550' oil, 3 hr
2500 A S/52 BOPH 3 hr
Comp 3000 BOPD

COMPLETED

DX-78

FORM 275 FOR SALE BY KANSAS BLUE PRINT CO.

County Graham State Kansas

Sec. 16 (Blk. / Twp.) 10 (Sur. / Rge.) 23W Map No.

Operator Birmingham & Bartlett

Well No. 1 Farm Stewart

Elev. Location NW NW NE



330 Ft. From N Line NE Quarter

330 Ft. From W Line

1st. Report FEB 23 1955

Completion

Remarks Co. tools

Spudding Date

Drlg. Data Hoof Pool

Location

FABEN GILSTRAP

FORM 275 FOR SALE BY KANSAS BLUE PRINT CO.


County Graham State Kansas

Sec. 16 (Blk. Twp.) 10 (Sur. Rge.) 23W Map No.

Operator Birmingham & Bartlett

Well No. 1 Farm Stewart

Elev. 2415 Location NW NW NE

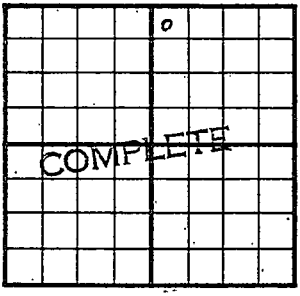

330 Ft. From N Line NE

330 Ft. From W Line Quarter

1st. Report

Completion MAR 23 1955

Remarks Hoof Pool

Co. tools

Spudding Date 2-24-55

Drlg. Data Oil well TD 3940

8" @ 245 Anhy 1959 Heeb. 3651

Tor. 3671 Lans. 3683 DST 3861-69

open 1 hr. gas in 27 min. Rec. 1380' oil

680# DST 3879-86 open 25 min. Rec.

50' mud 0# TD 3940 5" @ 3940

CO to 3907 24/ 3864-70 FU 1400' oil

1 hr. 1000# S/ 10 boph 4 hr.

SP 3858 24/ 3846-54 FU 2550' oil

3 hr. 2500 A S/ 52 boph 3 hr.

Comp. 3000 bopd

FABEN GILSTRAP