

Graham


KANSAS

SECTION 16 TOWNSHIP 10 RANGE 23 W

WELL NO. #1 Stewart

COMPANY Imperial Drlg.

NORTH

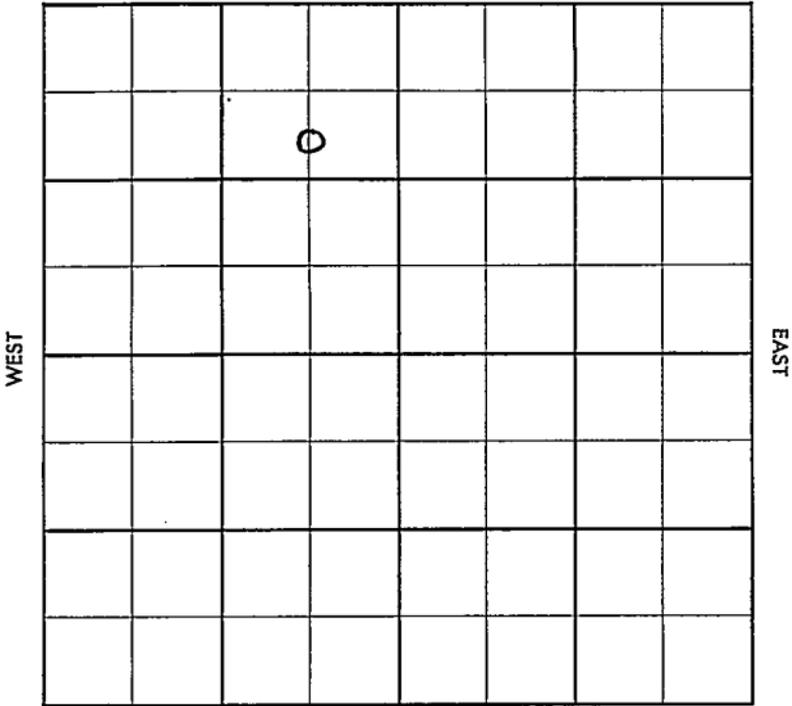

SOUTH

Graham

KANSAS

SEC. 16	TWP. 10	R. 23W
------------	------------	-----------

WELL NO. #4 Stewart FARM

COMPANY Imperial Drlg.

CONTRACTOR Co. Tools


Diebolt

\_\_\_\_\_ Ft. from N. Line

\_\_\_\_\_ Ft. from S. Line

\_\_\_\_\_ Ft. from E. Line

\_\_\_\_\_ Ft. from W. Line

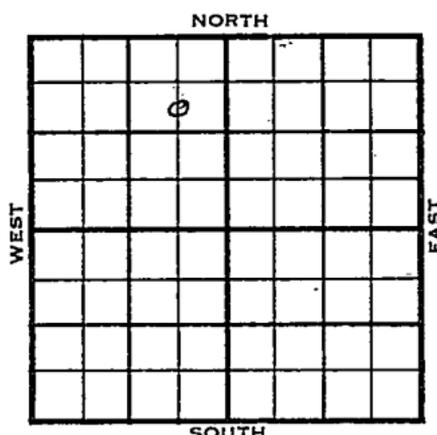C S  $\frac{1}{2}$  NE NW

1955	ELEVATION	REPORT
	2395'	
11-23	Comm. 11-17-55 8" @ 228 Drlg. 3350	
12-21	DST 3633-54 op 1 hr. rec. 480' GIP 1000' free oil, 1180/20" DST 3727-40 op 1 hr., 3100' GIP, rec 210' free oil, 1290/20" DST 3757-66 op 1 hr. gas to surface in 35 min. rec 1625' free oil, 10' <del>ocw</del> 1320/20" DST 3791-3806 op 70 min. gas to surface in 50 min. rec 55' socm, 320/20" 5 $\frac{1}{2}$ " @ 3855 CO 28/ 3855-39 1.78 boph, 30/ 3820- 25, 4.9 boph, 8000 A S/ 26 boph 12 hrs. Comp. BHB 2750 BOPD Anh. 1926 H. 3624 Tr. 3646 L. 3659 TD 3855'	

COMPLETED

County Graham Elev. \_\_\_\_\_  
 Sec. 16 Twp. 10 Rge. 23W  
 Company Imperial Drig.  
 Farm Name Stewart No. 4


TOPS	DEPTH	LOG	DATUM
Anh.			
Tp.			
H.			
Tr.			
Dg.			
Bl.			
L.			
K.C.			
B.K.C.			
Ce.			
C.			
M.			
M.			
K.			
Mz.			
Mq.			
V.			
S.			
S.			
A.			
R.			
Pe.			
G.			
T.D.			

Loc. in Sec. C S  $\frac{1}{2}$  NE NW

Geol. \_\_\_\_\_  
 Contr. \_\_\_\_\_  
 Co. tools MAAPPY  
 Pool 1000

FIRST REPORT  
 NOV 23 55

Date Comm. 11-17-55  
8" @ 228 drig. 3350

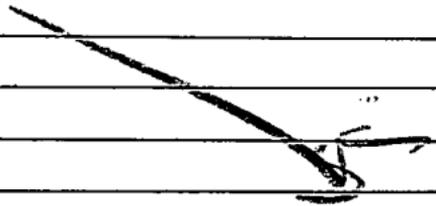

Co.  
Lse.  
No.  
Sec.  
T.  
R.

County Graham Elev. 2395  
 Sec. 16 Twp. 10 Rge. 23W  
 Company Imperial Drlg.  
 Farm Name Stewart No. 4

TOPS	DEPTH	LOG	DATUM	Loc. in Sec.
Anh.	1926			C S $\frac{1}{2}$ NE NW
Tr.				
H.	3624		1229	
Tr.	3646		1254	
Dg.				
Bl.				
L.	3659		1264	
K.C.				Geol.
B.K.C.				Contr.
Ce.				Co, tops
C.				HAPPY
M.				
M.				Diebolt
K.				
Mz.				
Mq.				
V.				
S.				
S.				
A.				
R.				
Pe.				
G.				
T.D.	3855			

Co, tops  
 HAPPY  
 Diebolt


COMPLETE

Date Comm. 11-17-55 DEC 21 1955

8" @ 228 DST 3633-54 open 1 hr.

rec. 480' gip 1000' free oil 1180/20"

DST 3727-40 open 1 hr. 3100' gip

Rec. 210' free oil 1290/20" DST 3757-66

open 1 hr. gas to surface in 35 min.

rec. 1625' free oil 10' ocw 1320/20"

DST 3791-3806 open 70 min. gas to surface

in 50 min. rec. 55' soem 320/20"

5 $\frac{1}{2}$ " @ 3855 CO 28/ 3835-39 1.78 boph

30/ 3820-25 4.9 boph 8000 A

S/ 26 boph 12 hr. Comp. BHB 2750 bopd

R. G.

JAN-4 1956