


Section 16 Township 10 Range 23W

Well No. #2 Stewart. "A"

Company Imperial Drlg.

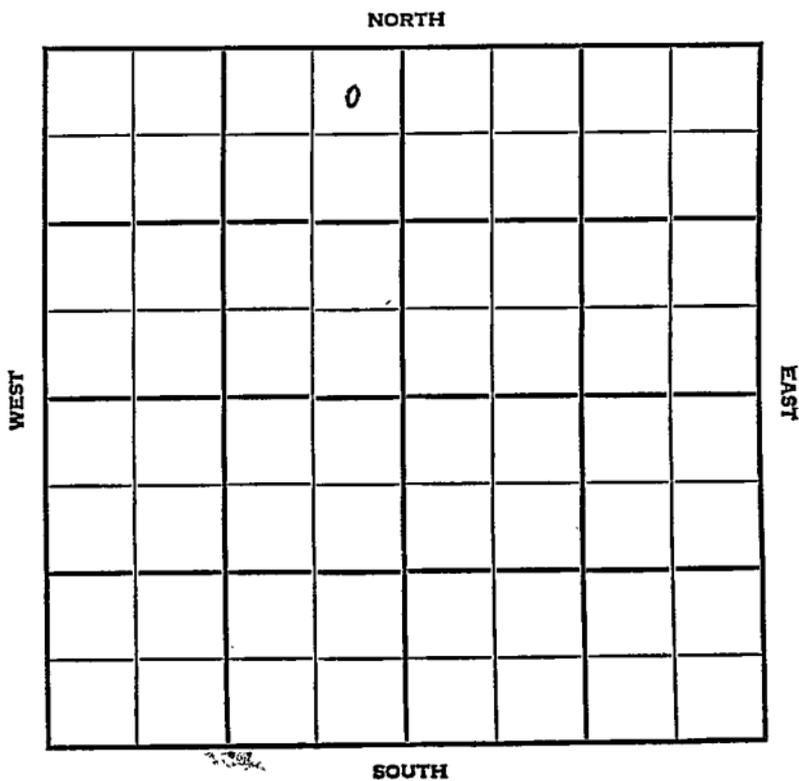

SEC. <b>16</b>	TWP. <b>10</b>	R. <b>23W</b>
WELL NO. <b>#2 Stewart "A"</b>		
FARM		
COMPANY <b>Imperial Drlg.</b>		
CONTRACTOR		

Co. Tools.


Hoof Pool

330 Ft. from N. Line

\_\_\_\_\_ Ft. from S. Line

330 Ft. from E. Line

\_\_\_\_\_ Ft. from W. Line

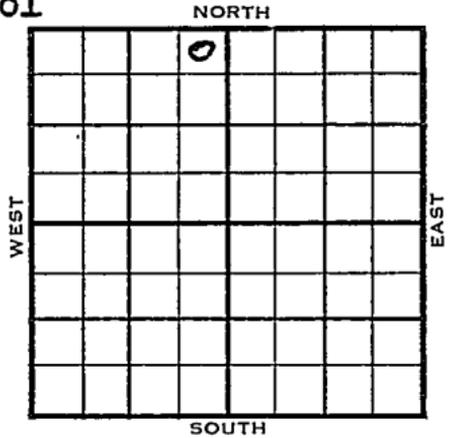

NE NE NW

	ELEVATION	REPORT
1955	<b>2414'</b>	
2/9		Spud 2-4-55 8" @ 222' Anhy 1949' Drlg. 2555'
3-16-55		Spud 2-4-55 Oil Well TD 3901 8" @ 222' Anhy 1949 Heeb 3643, Lans 3675, DST 3688-3702 open 1 hr gas in 24 min. Rec 2686' oil 1290# TD 3883 5" @ 3875 CO to 3883 1000A S/1 BOPH DD 3901 S/ 1 1/2 BOPH 3 hr SP 3865 18/3855-58 B/1/2 GOPH 32/3839-44 B/ 1/2 BOPH 3000 A S/18 1/2 BOPH 1000A S/25 BOPH Comp. BHP 2105 BOPD

**COMPLETED**



