


Section 16 Township 10 Range 23W

Well No. #2 Phy Stewart.

Company Skelly Oil

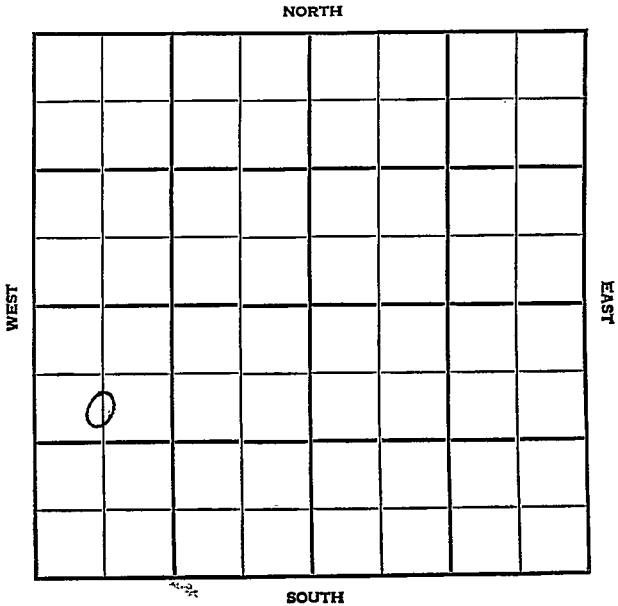

Graham

SEC.	TWP.	R.
16	10	23W


WELL NO. #2 Phy Stewart. FARM

COMPANY Skelly Oil

CONTRACTOR

Happy Pool

990 Ft. from N. Line
 _____ Ft. from S. Line
 _____ Ft. from E. Line
 660 Ft. from W. Line

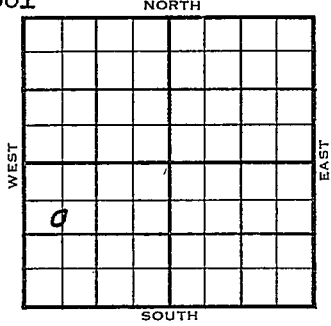

C S 1/2 NW SW

	ELEVATION	REPORT
1955		
4/13	RUR	

County Graham State Kansas

Sec. 16 (Blk. Twp.) 10 (Sur. Rge.) 23W Map No.

Operator Skelly Oil

Well No. 2 Farm Fhy Stewart

Elev. Location C S $\frac{1}{2}$ NW SW

990 Ft. From N Line SW

660 Ft. From W Line Quarter

1st. Report APR 13 1955

Completion _____

Remarks _____

Spudding Date _____

Drig. Data. Happy Pool

RUR

FABEN GILSTRAP