


DX 78-1 Graham

KANSAS

Section 16 Township 10 Range 23W

Well No. 3 Phy Stewart

Company Skelly Oil

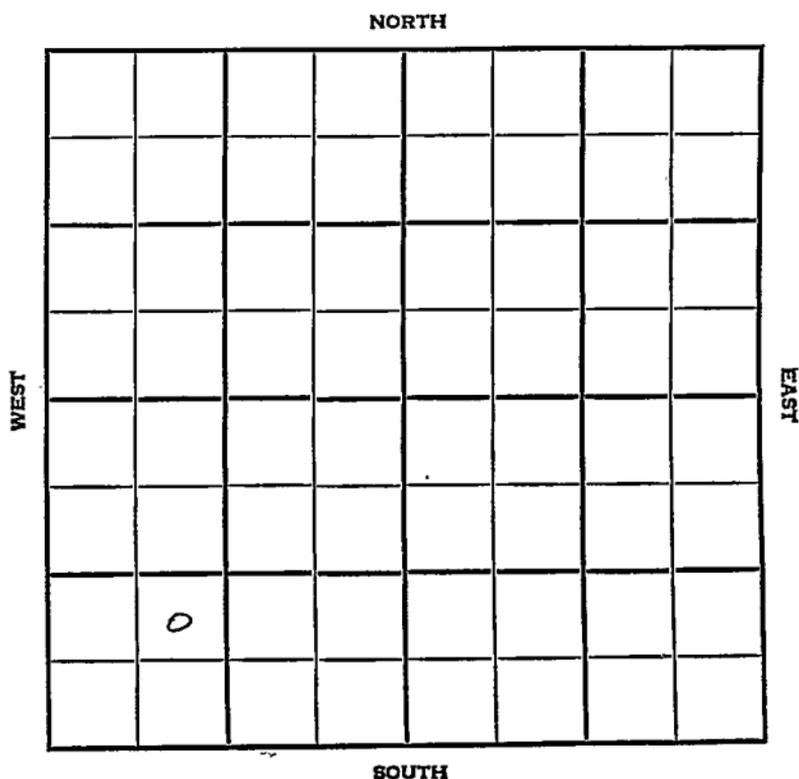

Graham KANSAS

SEC.	TWP.	R.
16	10	23W
WELL NO.		
3 Phy Stewart		FARM
COMPANY		
Skelly Oil		
CONTRACTOR		


Happy Pool

_____ Ft. from N. Line

990 _____ Ft. from S. Line

_____ Ft. from E. Line

990 _____ Ft. from W. Line

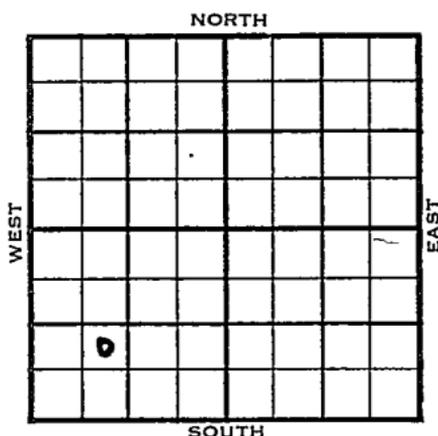

NE SW SW

1955	ELEVATION	REPORT
	2344	

4/27
6/1

Location

Comm 4-25-55
 8 5/8" @ 278/175 DST 3582-3610 open
 1 hr. Rec. 10' socm 30# DST 3651-57
 open 1 hr. Rec. 700' oil 425' vocm
 1125' hocw DST 3688-3701 open 1 hr. Re
 Rec. 480' gassy oil 40' ocm 1215# DST
 3768-74 open 1 hr. Rec 1550' oil 505#
 DST 3776-99 open 1 hr. Rec. 2467' gip
 352' hmco 505# 5 1/2" @ 3859 GO to 3821
 99/3784-95 10 goph 1250 A S/100 bo 2
 hr. PB 3779 81/3766-75 FU 1800' oil
 4 hr. 1250A S/66 bo 2 hr. DP to 3821
 P/27 bo 1 hr. Comp BHB 3000 bopd.

Tops:	Depth	Datum
H.	3575	1231
Tr.	3595	1251
L.	3660	1266
TD	3875	

COMPLETED

County Graham State Kansas

Sec. 16 (Blk. Twp.) 10 (Sur. Rge.) 23W Map No.

Operator Skelly Oil

Well No. 3 Farm Phy Stewart

Elev. _____ Location NE SW SW

990 Ft. From S Line SW

990 Ft. From W Line Quarter

1st. Report APR 27 1955

Completion _____

Remarks _____

Spudding Date _____

Drig. Data Happy Pool

Location _____

K-5
Happy Pool

FABEN GILSTRAP

County Graham ✓ Elev. 2344
 Sec. 16 Twp. 10 Rge. 23W
 Company Skelly Oil
 FarmName Phy Stewart No. 3

TOPS	DEPTH	LOG	DATUM
Anh.			
TP.			
H.	<u>3575</u>		<u>1231</u>
Tr.	<u>3595</u>		<u>1251</u>
Dg.			
BL.			
L.	<u>3660</u>		<u>1266</u>
K.C.			
B.K.C.			
Ce.			
C.			
M.			
M.			
K.			
Mz.			
Me.			
V.			
S.			
S.			
A			
R.			
Pe.			
G.			
TD.	<u>3875</u>		

Loc. in Sec. NE SW SW

Geol. _____

Contr. _____

Pool Happy

COMPLETE

Date Comm. 4-25-55 JUN 1 1955
8 5/8" @ 278/175 DST 3582-3610 open 1 hr
Rec. 10' socm 30# DST 3651-57 open
1 hr. Rec. 700' oil 425' vocm 1125'
hocw DST 3688-3701 open 1 hr.
Rec. 480' gassy oil 40' ocm 1215#
DST 3768-74 open 1 hr. Rec. 1550' oil
505# DST 3776-99 open 1 hr. Rec.
2467' gip 352' hmco . 505# 5 1/2" @ 3859

OVER

CO to 3821 99/ 3784-95 10 goph

1250 A S/ 100bb 2 hr. PB 3779

81/ 3766-75 FU 1800' oil 4 hr.

1250A S/ 66 bo 2 hr. DP to 3821

P/ 27 bo 1 hr.

Comp. BHB 3000 bopd

.....	Misc.
.....	Pierce Map
.....	France Map
.....	Tracings
.....	Land Well Map
.....	Land Small Map
.....	Scout Cards

J.C.