


Section 16 Township 10 Range 23 WWell No. # 7 Phy StewartCompany Skelly Oil

NORTH

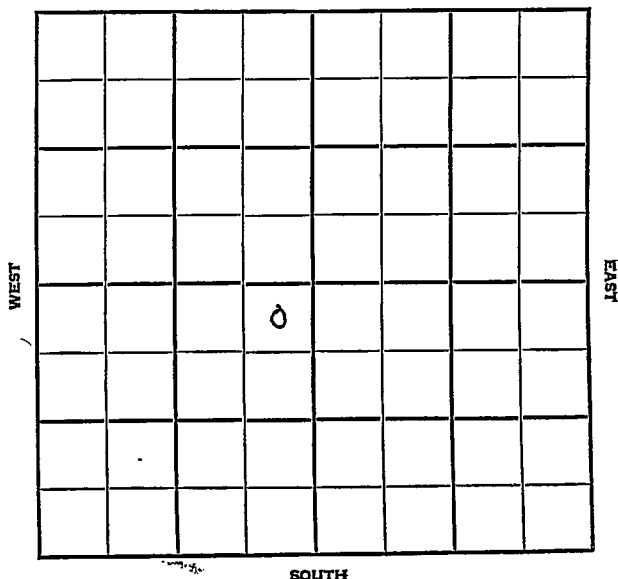

Graham

KAINSA

SEC.	TWP.	R.
16	10	23W

WELL NO.

#7 Phy Stewart

FARM

COMPANY

Skelly Oil

CONTRACTOR

Wentworth


Happy

Ft. from N. Line

Ft. from S. Line

Ft. from E. Line

Ft. from W. Line

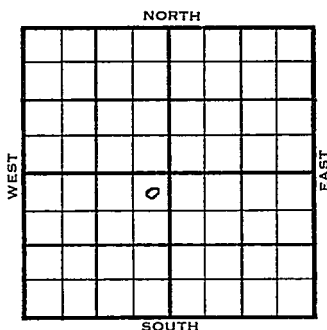

NE NE SW

	ELEVATION	REPORT
1955	2392'	
7/27	Comm 7-24-55	
	8" @ 278/200	
8/31	Comm 7-24-55	
	H 3644	
	Tr 3666	
	L 3678	
	BKC 3904	
	Marm Cht 4009	
	Marm Sd 4090-96	
	K Congl 4123	
	TD 4168	
	8" @ 278 w/200	
	DST 3683-3736 op 1 hr Rec 12' r mud	
	BHP 450; DST 3736-73 op 1 hr. rec 240'	
	oil and gw gcwm 240' gcw, BHP 1240#	
	DST 3828-50 op 1 hr Rec 10' mud sp of	
	oil, BHP 60#; DST 3846-69 op 1 hr. rec	
	5' mud BHP 0#; DST 3864-85 op 1 hr. rec	
	5' mud BHP 60#; 5 1/2" @ 4159; CO 4123;	
	27/3852-55; 500 A; swb 69 bw 10 hrs;	
	PB 3847; 27/3839-42; 250 A; test 3 go	
	2' gw 6 hrs; 1000A; swb 18 bw 6 hrs;	
	PB 3776; 36/3760-64 250 A; swb 69 BW	
	6 hrs.	
	D & A	
		ABANDONED

County Graham Elev. _____
 Sec. 16 Twp. 10 Rge. 23W
 Company Skelly Oil
 Farm Name Phy Stewart No. 7

TOPS	DEPTH	LOG	DATUM
Anh.			
T.P.			
H.			
Tr.			
Dg.			
BL.			
L.			
K.C.			
B.K.C.			
Ce.			
C.			
M.			
M.			
K.			
Mz.			
Mq.			
V.			
S.			
S.			
A			
R.			
PE.			
G.			
T.D.			

Loc. in Sec. _____

NE NE SW

Geol. _____

Contr. _____

Wentworth

Pool _____

Happy

FIRST REPORT

JUL 27 '55

Date Comm. 7-24-55


8" @ 278/200

~~Happy~~

5

County Graham Elev. 2392
 Sec. 16 Twp. 10S Rge. 23W
 Company Skelly Oil
 Farm Name Phy Stewart No. 7

TOPS	DEPTH	LOG	DATUM	Loc. in Sec.
Anh.				NE NE SW
TP.			1252	
H.	3644		1274	
Tr.	3666			
Dg.				
BL.				
L.	3678		1286	
K.C.				Geol.
B.K.C.	3904		1512	Contr.
Ce.				Wentworth
C.				
Marm cht	4009		1617	Pool
Marm Sd.	4090-96		1698	Diebolt
K. Congl	4123		1731	
Mz.				
Me.				
V.				
S.				
S.				
A				
R.				
Pe.				
G.				
T.D.	4168			

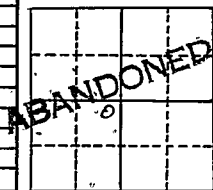

Date Comm. 7-24-55 AUG 3 1 1955
 8" 278 w/200; DST 3683-3736 op 1 hr. rec.
 12' r mud BHP 450; DST 3736-73 op 1 hr.
 rec 240' oil and gcwm 240' gcw, BHP 1240#
 DST 3828-50 op 1 hr. rec. 10' mud sp of
 oil, BHP 60#; DST 3846-69 op 1 hr., rec. 5'
 mud BHP 0#; DST 3864-85 op 1 hr. rec. 5'
 mud, BHP 60#; 5 1/2" 4159; CO 4123; 27/3852-55;
 500 A; swb 69 bw 10 hrs.; PB 3847;
 27/3839-42; 250 A; test 3 go 2 gw 6 hrs.;

OVER

1000 A; swb 18 bw 6 hrs.; PB 3776; 36/3760-64
250 A; swb 69 bw 6 hrs..

D & A

_____	Misc.
_____	Pierce Map
_____	France Map
_____	Tracings
_____	Land Wall Map
_____	Land Small Map
_____	Scout Cards

5277

SEP 8 1955