

KANSAS

Well No. 4 Custer

Company SUNray Oil

WEST

EAST

SOUTH

Graham KANSAS

SEC.	TWP.	R.
17	10	23W

WELL NO.

4 Custer

FARM

COMPANY

Sunray Oil

CONTRACTOR

Stickle Drlg.


Happy Pool

990 _____ Ft. from N. Line

_____ Ft. from S. Line

660 _____ Ft. from E. Line

_____ Ft. from W. Line

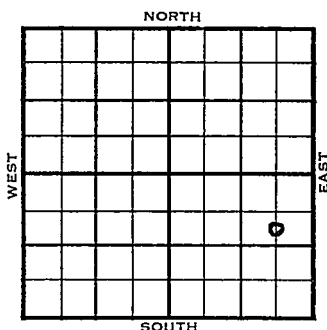

C S/2 NE SE

	ELEVATION	REPORT
1955	2383'	

3/30 Location

5/25 Heeb 3628; Tor 3650; Lsg. 3662; BKC 3889;
 TD 3905; 8 5/8" 277; DST 3817-37 open 30 min, gas in 25 min, rec 700'
 gassy oil plus 20' gas and ocm, 450#;
 DST 3841-55 open 30 min, rec 480'
 gip plus 60' clean oil * 10' oil
 and gcm, 505#; RTD 3903; 5 1/2" 3899;
 CO 3880; 24/3836-40; test 20 goph
 3 hrs; 1200 A; swb 31 bo 3 hrs; plug
 3830; 24/3824-28; test 6.68 boph
 4 hrs; 1750 A; test 25 boph 4 hrs;
 CO 3880; pmp 65 bo no wtr. 5 hrs;
 phy mpm 321 bopd no wtr from lsg
 3824-28, 3836-40

COMPLETED

FABEN GILSTRAP