


Section 17 Township 10 Range 20-W

Well No. #2 Teall

Company Heathman Drlg.

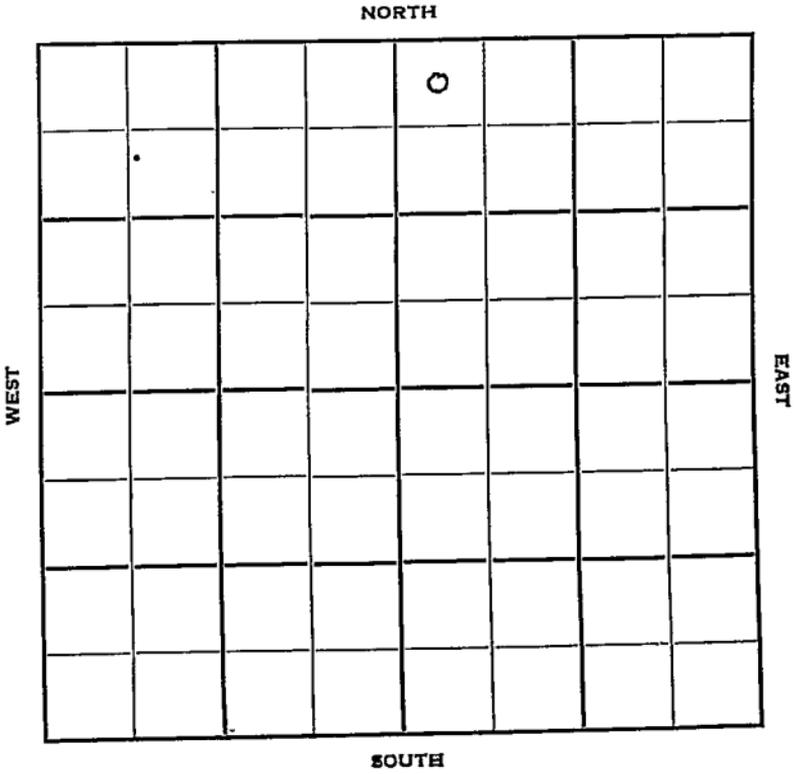

Sec. 17 Twp. 10 R. 20-W

Well No. #2 Teall Farm

Heathman Drlg. Company

Contractor

Wildcat


330 Ft. from N. Line

Ft. from S. Line

Ft. from E. Line

330 Ft. from W. Line

NW NW NE

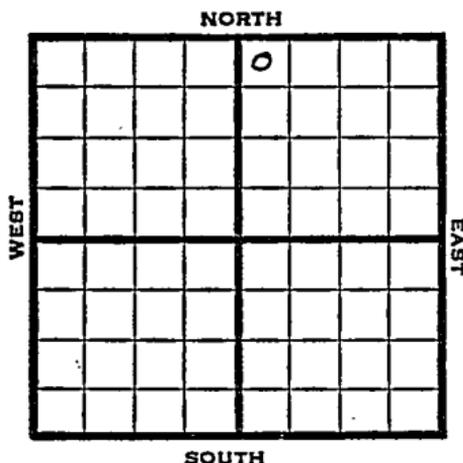

1950

Elev 2254

REPORT

7/19

Location

8/16

8 5/8" @ 128

Anhy 1741

Top 3293

Heeb 3498

Lans 3538

DST 3468-90 opn 15 min rec 30' sw

B KC 3764

Cong 3806

Simp 3835

Arb 3850

DST 3837-56 opn 1 hr rec 32' sw

TD 3875

D&A

ABANDONED

Kansas

Wildcat

Map No. _____ Sec. 17 Twp. 10 R. 20W

Well No. 2 Teall

Heathman Drlg. _____ Company

_____ Contractor

NW NW NE


330 Ft. from N. Line

_____ Ft. from S. Line

_____ Ft. from E. Line

330 Ft. from W. Line

SECTION PLAT

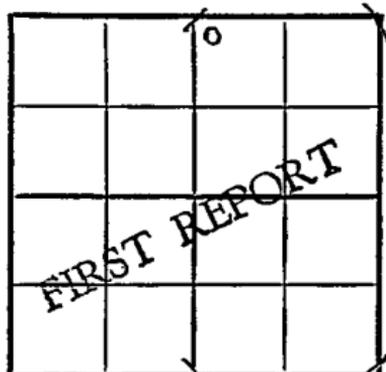

Rooks County

Location x

Rig up

Drilling and Remarks:

RECORD

Cased _____ in., _____ ft.

Sand _____

Gas _____

Oil _____

Total Depth _____

PRODUCTION

1st 24 hrs. Nat. _____

1st 24 hrs. after shot _____

Gas _____ Cu. Ft.

Dry Hole _____

Abandoned _____

Date

JUL 19 1950

19

J. E. TYRA

Scout


County _____ Rocks _____ State Kansas

Sec. 17 (^{Blk.}_{Twp.}) 10 (^{Sur.}_{Rge.}) 20W Map No. _____

Operator Heathman Drlg.

Well No. 2 Farm Teall

Elev. 2254 Location NW NW NE

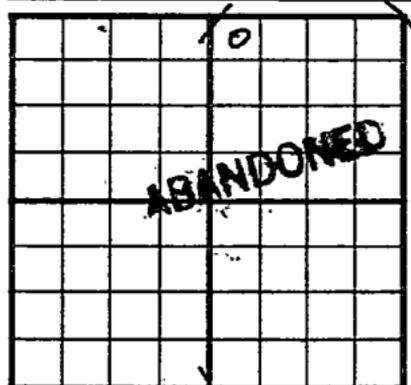

330 Ft. From N Line NE

330 Ft. From W Line Quarter

1st. Report

Completion AUG 16 1950

Remarks

Spudding Date 7-22-50

Drlg. Data D & A 3875

8 5/8" @ 128 Anhy 1741 Top. 3293

Heeb. 3498 Lans. 3538 DST 3468-90

open 15 min. Rec. 30' sw DST 3720-70

open 30 min. Rec. SW B KC 3764

Cong. 3806 Simp. 3835 Arb. 3850

DST 3837-56 open 1 hr. Rec. 32' SW

TD 3875 D & A

J. E. TYRA