


Section 17 Township 10 Range 20 W

Well No. # 1 Desbian

Company Malonee Drlg.

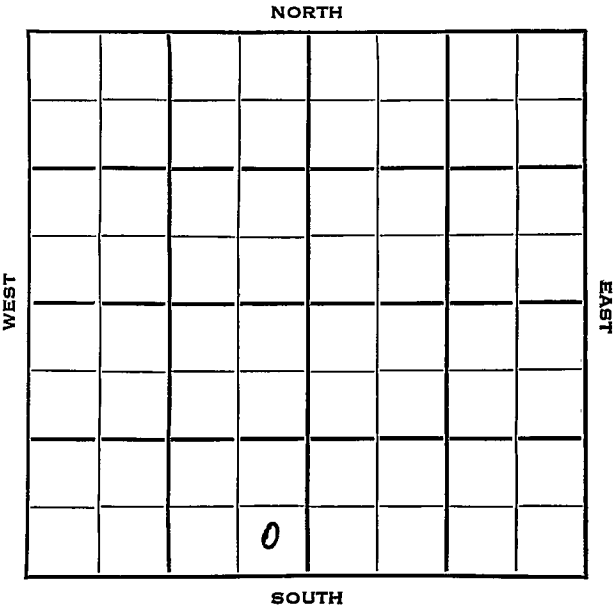


Rooks

KANSAS

Sec. 17 Twp. 10 R. 20 WWell No. # 1 Desbian FarmMalonee Drlg. CompanyMalonee Drlg. ContractorAmboy Pool Ft. from N. Line330 Ft. from S. Line330 Ft. from E. Line Ft. from W. Line

SE SE SW

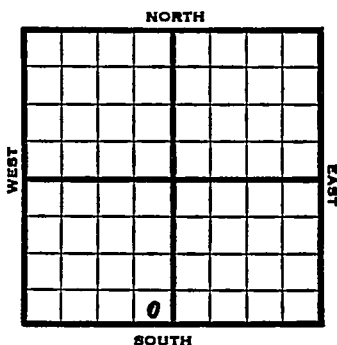

1953

Elev. 2200'

REPORT

8/26

MTM

9/2

8" @ 210' w/135 sks
 Anhy 1698'
 Drlg 2625'

9/9

Heeb 3458, Tor 3479, KC 3496, B KC
 3718, Cong 3820

9/16

Spud 8-28-53 D & A TD 3873
 8" @ 210 Anhy 1698' Heeb 3458'
 Tor. 3479 KC 3496 B KC 3718'
 Cong 3820' TD 3873' D & A

ABANDONED

County Rooks State Kansas

Sec. **17** (Blk. **10** (Sur. **20W** Map No.

Operator Malonee Drlg.

Well No. **1** Farm **Desbian**

Elev.	Location	SE	SE	SW
-------	----------	----	----	----

0

330 Ft. From S Line SW

330 Ft. From E Line Quarter

1st. Report **AUG 26 1953**

Completion _____


Remarks

Malonee Drig. - Contr.

Spudding Date _____

Drlg. Data Amboy Pool

III

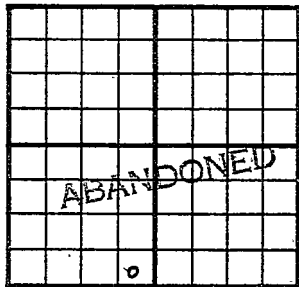County _____ Rooks _____ State KanSec. 17 (Blk.
Twp.) 10 (Sur.
Rge.) 20W Map No. _____Operator Malonee Drlg.Well No. 1 Farm DesbianElev. 2200 Location SE SE SW330 Ft. From S Line SW330 Ft. From E Line Quarter1st. ReportCompletion SEP 16 1953Remarks Amboy PoolMalonee Drlg. - Contr.Spudding Date 8-28-53Drlg. Data D & A TD 38738" @ 210 Anh 1698 Heeb. 3458Tor. 3479 KC 3496 B KC 3718Cong. 3820 TD 3873D & A