

15-103-30223

KANSAS GEOLOGICAL SOCIETY
KANSAS WELL LOG BUREAU - KANSAS WELL SAMPLE BUREAU
KANSAS GEOLOGICAL SOCIETY BUILDING
508 EAST MURDOCK - WICHITA, KANSAS



COMPANY **DAVIS BROS-TRANSIT CORP**

SEC. 8 T. 10 R. 17W
 LOC. SE NE SW

FARM **Plante "B"** NO. 2

TOTAL DEPTH **3577'**
 COMM. **10-6-66** COMP. **10-13-66**
 SHOT OR TREATED
 CONTRACTOR **Transit C**
 ISSUED **1-7-67**

COUNTY **Rooks**

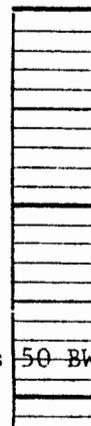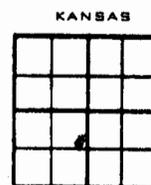

CASING
 20 10
 15 8 5/8" 152' cem w/ 100 sx
 12 6
 13 5

ELEVATION **2098 KB**

PRODUCTION **75 BO Plus 50 BWPD**
(Lans 3432-3526)

FIGURES INDICATE BOTTOM OF FORMATIONS

Clay	0	105
Blue shale	105	152
Shale	152	880
Sand	880	1085
Red bed	1085	1376
Anhydrite	1376	1412
Shale	1412	1450
Shale and shells	1450	2075
Shale and lime	2075	2290
Lime	2290	2400
Lime and shale	2400	2595
Shale and lime	2595	2970
Lime and shale	2970	3077
Shale and lime	3077	3165
Lime and shale	3165	3235
Lime	3235	3339
Lime and shale	3339	3405
Lime	3405	3535
Lime and chert	3535	3577 T. D.

Anhydrite	1376-1412
Topeka	3032
Heebner	3255
Toronto	3270
Lansing	3295
Base Kansas City	3527
Conglomerate	3552

I hereby certify the foregoing to be a true and correct
 Drillers' Log of the formations encountered in the above
 well.

Subscribed and sworn to before **TRANSIT CORPORATION**
 me this 19th day of October,
 1966

By *L. J. Kruse*

My commission expires January 3, 1970

Paul E. Galt
 Notary Public