


Graham

KANSAS

SECTION 18 TOWNSHIP 10S RANGE 25W

WELL NO. #2 Krug "A"

COMPANY Empire Drlg. & NCRA

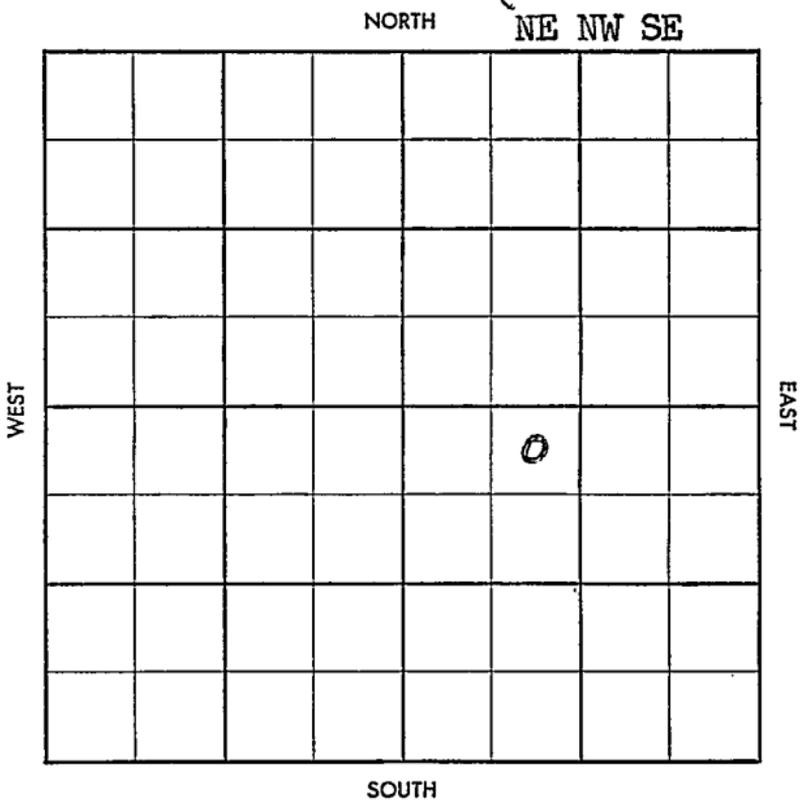

Twp. ~~X~~ Pool ~~X~~
~~G.S.~~ ~~F.S.~~

S-513-B

County Graham Elev. _____
 Sec. 18 Twp. 10 Rge. 25W
 Company Empire Drlg. & N.C.R.A.
 Farm Name Krug "A" No. 2

TOPS	DEPTH	LOG	DATUM
Anh.			
Tp.			
H.			
Tr.			
Dg.			
B.L.			
L.			
K.C.			
B.K.C.			
Ce.			
C.			
M.			
M.			
K.			
Mz.			
Mq.			
V.			
S.			
S.			
A.			
R.			
Pf.			
G.			
T.D.			

Loc. in Sec. _____
NE NW SE


 Geol. _____
 Contr. _____
Empire Drlg.
 Pool _____
Gurk

APR 2 1958
FIRST REPORT

Date Comm. 3/28/58
8" @ 153 w/100, TSD

Co. _____

3

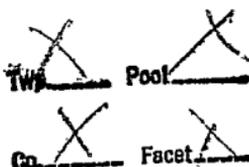

S-513-B 7

County Graham Elev. 2312 LF 25 in RA
 Sec. 18 Twp. 10 Rge. 25W
 Company Empire Drlg. & N.C.R.A.
 Farm Name Krug "A" No. 2

TOPS	DEPTH	LOG	DATUM
Anh.	2172		
Tp.			
H.	378 8		
Tr.	3873		
Dg.			
B.L.			
L.	3830	-12 5/8	
K.C.			
B.K.C.			
Ce.			
C.			
M.			
M.			
K.			
Mz.			
Mq.			
V.			
S.			
S.			
A.			
R.			
Pf.			
G.			
T.D.	4020		

Loc. in Sec. NE NW SE
 Geol. _____
 Contr Empire Drlg.
 Pool Gurk

COMPLETE
 MAY 23 '58

Date Comm. 3/28/58
 8" @ 153 w/100, TSD APR 12 58 Ø 2590 APR 14 58

DST 3849-62 0 pl/hr 10' 50cm BHP
 0/30" DST 3862-80 0 pl/hr 65' 0cm
 60' w. 0cm 120' MW FPO -160 BHP
 Ø 20/30" Ø 3900 APR 23 58 DST 3956-70
 1 hr 600' gip 60' 0cm 60' VSMCO. SP
 0 BHP 1380/30" DST 3991-4020 0/30"
 30' M SCUM oil FPO BHP 0/30" Log
 5" 4019 WOCT APR 30 58 Ø 3980 24"
 3962-68 1) Ø 6 BOPH NW 6 hrs POP

MAY 7 '58

MAY 14 '58

MAY 21 '58

MAY 28 '58

51-10-153.730 NW 24 has

18-10-25W

revised