

Section 18 Township 10 Range 17WWell No. #1 GavertCompany Champlin Ref.

0								

NORTH

WEST

EAST

SOUTH

13

Rooks

KANSAS

Sec. 18 Twp. 10 R. 17 WWell No. # 1 Gavert Farm

Champlin Ref. Company

Wentworth Contractor

Wildcat


Ft. from N. Line

330 Ft. from S. Line

Ft. from E. Line

330 Ft. from W. Line

SW SW SW

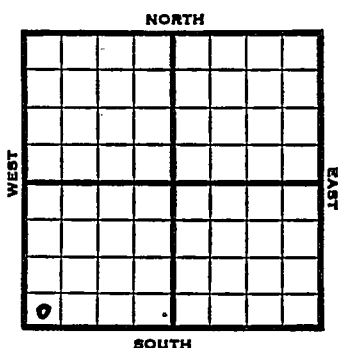

1953 Elev. 2140' REPORT

2/11 Spud 2-7-53
8" @ 160
Drlg. 560'

2/19 Heeb 3335 Lans 3378
Drlg. 3478'

2/26 Cong 3652'
DST 3537-75, 1 hr, weak blow 12",
15' M Off
DST 3577-3605, 1/2 hr, weak blow, 8'
M Off
Simp. 3705' Arb. 3746' RTD 3756'
DST 3641-60, 1/2 hr, good blow, 600'
free oil, 30' muddy oil 1030# 15"
DST 3660-70, 1/2 hr, weak blow,
5", 12' M Off
SLM 3475 equals 3468'
5" @ 3756'

3/12 CO 3756 30/3648-58 S/130 BF 18 hrs
7% wtr. G. 27

3/19 NR

3/26 NR

4/2 NR

4/8 Spud 2-7-53

OVER

1953

4/8

Information brought forward

TD-3753

8" @ 160'

Heeb 3335, Lans 3378, Cong 3652,

DST 3537-75 open 1 hr. Rec 15' mud

0# DST 3577-3605 open $\frac{1}{2}$ hr. Rec 8'
mud 0#

Simp 3705, Arb 3746,

TD 3756

DST 3641-60 open $\frac{1}{2}$ hr. Rec 600' free
oil, 30' muddy oil, 1030#

DST 3660-70 open $\frac{1}{2}$ hr. Rec 12' mud 0#

SIM 3475-3468

5" @ 3756

CO to 3756

30/ 3648-58 S/ 130 bf 18 hr. 7% wtr.

P/ 4 boph 13% wtr.

Comp. 53 bopd 34% wtr.


SCHLUMBERGER TOPS:

Heeb 3330, Lans 3372, Cong 3648, Arb
3742

TD 3753

COMPLETED

County Rooks State Kansas
 Sec. 18 (Blk. 10 (Sur. 17W Map No.)
 Operator Champlin Ref.
 Well No. 1 Farm Gavert
 Elev. Location SW SW SW

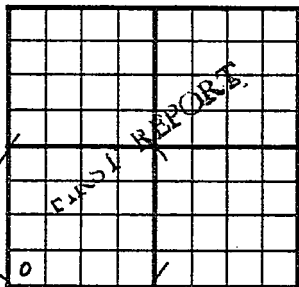

330 Ft. From S Line SW
330 Ft. From W Line Quarter

1st. Report FEB 11 1953

Completion

Remarks


Wentworth - Contr.

Spudding Date 2-7-53

Drlg. Data Wildcat

8" @ 160 drlg. 560

J. G. McGEHEE

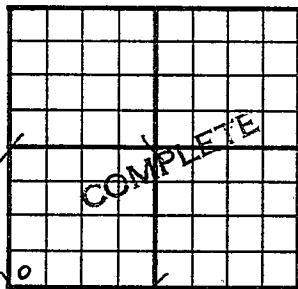County _____ Rocks _____ State KansasSec. 18 (Blk. Twp.) 10 (Sur. Rge.) 17W Map No. _____Operator Champlin Ref.Well No. 1 Farm GavertElev. 2140 Location SW SW SW330 Ft. From S Line SW330 Ft. From W Line Quarter

1st. Report _____

Completion APR 8 1953Remarks WildcatWentworth - Contr.Spudding Date 2-7-53Drlg. Data Oil well TD 37538" @ 160 Heeb. 3335 Lans. 3378Cong. 3652 DST 3537-75 open 1 hr.Rec. 15' mud 0# DST 3577-3605 open $\frac{1}{2}$ hrRec. 8' mud 0# Simp. 3705 Arb. 3746TD 3756 DST 3641-60 open $\frac{1}{2}$ hr.Rec. 600' free oil 30' muddy oil 1030#DST 3660-70 open $\frac{1}{2}$ hr. Rec. 12' mud 0#SLM 3475-3468 5" @ 3756 CO to 375630/ 3648-58 S/ 130 bf 18 hr. 7% wtr.P/ 4 boph 13% wtr.Comp. 53 bopd 34% wtr.SCHLUMBERGER TOPSHeeb. 3330 Lans. 3372 Cong. 3648Arb. 3742 TD 3753

J. G. McGEHEE