


Section 18 Township 10 Range 19W

Well No. #6 Anderson

Company Sinclair Oil & Gas

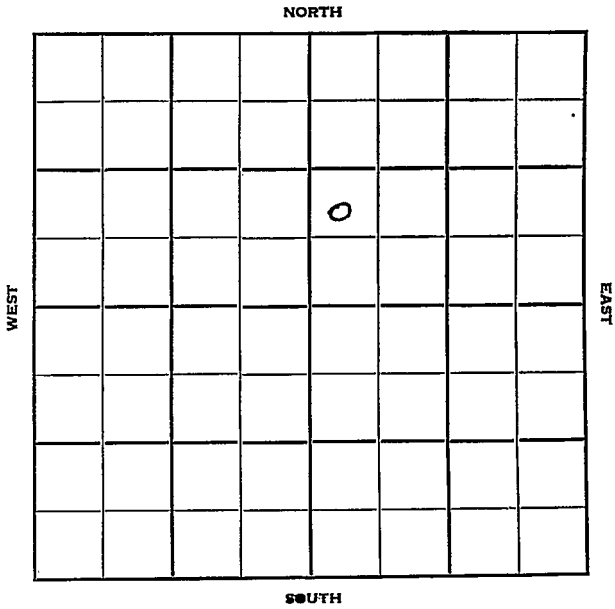

Rooks

Sec. 18 Twp. 10 R. 19W

Well No. #6 Anderson Farm

Sinclair Oil & Gas Company

Harbar Drlg. Contractor
Berland Pool


 Ft. from N. Line

990' Ft. from S. Line

 Ft. from E. Line

330' Ft. from W. Line

NW SW NE

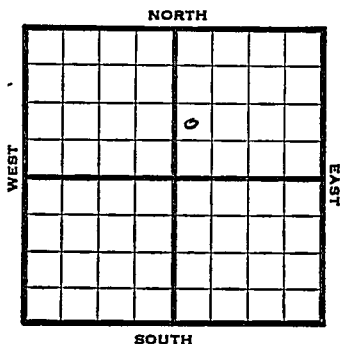

1950.

Elev. 2226' REPORT

12/27

Location

1951

1/24

Spud 12-28-50
Oil Well TD 3795
8" @ 153' Top. 3222'
Lans. 3473' Cong. 3722
Simp. 3765' Arb. 3786'
DST 3788-95 opn 1/2 hr
Rec. 190' clean oil 20' ocm
100' oily mud 5" @ 3790
TD 3795 FU 150' oil in 1/2 hr
S/7 boph 1500 A S/45 bo in 5 hr
Comp. 204 bopd

COMPLETED

County Rooks State Kansas

Sec. 18 (Blk. 10) (Sur. 19W) Map No. 19W

Operator Sinclair Oil & Gas

Well No. 6 Farm Anderson

Elev. 2226 Location NW SW NE

990 Ft. From S Line NE

330 Ft. From W Line Quarter

1st. Report

Completion JAN 24 1959

Remarks Berland Pool

Harbar Drlg. - Contr.

Spudding Date 12-28-50

COMPLETE

Drlg. Data Oil well TD 3795

8" @ 153 Top. 3222 Lans. 3473

Cong. 3722 Simp. 3765 Arb. 3786

DST 3788-95 open 1/2 hr. Rec. 190' clean

oil 20' ocm 100' oily mud 5" @ 3790

TD 3795 FU 150' oil in 1/2 hr. S/ 7 boph

1500 A S/ 45 bo in 5 hr.

Comp. 204 bopd

J. E. TYRA