

KANSASSection 18 Township 10 Range 19WWell No. 4 ScogginsCompany SkellyBerland

NORTH

WEST

EAST

SOUTH

0

KANSAS

Rooks

Sec. 18 Twp. 10 R. 19W

Well No. #4 Scoggins Farm

Skelly

Company

Berland Pool (Herndon Drlg., Cont.) NORTH


 Ft. from N. Line

330' Ft. from S. Line

990' Ft. from E. Line

 Ft. from W. Line

SW SE SW

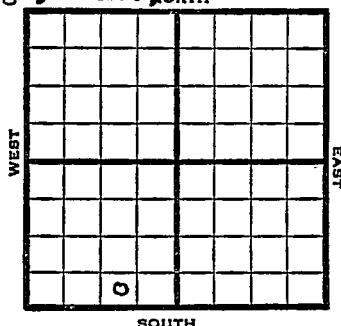

1949 . Elev. 2230' REPORT

5/18 Drlg. 1495'

5/25 8" @ 1636'

Drlg 3414'

6/1 Lans 3475'

Arb. 3795'

TD 3830'

5" @ 3830'

6/7 "

6/15 39 shots 3795-3799

CO

6/22 Arb 3795'

5" @ 3830'

Perf Arb

3000 acid

Pump 165 oil Pot.

Grv. 27°

TD 3830'

COMPLETED

Map No. _____ Sec. 18 Twp. 10 R. 19W

Well No. 4 Scoggins

Skelly Company

Herndon Drlg. Contractor

SW SE SW


**FIRST REPORT
SECTION PLAT**

_____ Ft. from N. Line

330 Ft. from S. Line

990 Ft. from E. Line

_____ Ft. from W. Line

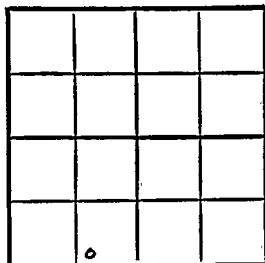

Rooks County

Location _____

Rig up _____

Drilling and Remarks:

drlg. 1495

RECORD

Cased _____ in., _____ ft.

Sand _____

Gas _____

Oil _____

Total Depth _____

PRODUCTION

1st 24 hrs. Nat. _____

1st 24 hrs. after shot _____

Gas _____ Cu. Ft.

Dry Hole _____

Abandoned _____

Date

MAY 18 1949

19

S. J. LEWIS Scout

Kansas

Berland Pool

Map No. K65 Sec. 18 Twp. 10 R. 19WWell No. 4 Scoggins

Skelly

Company

COMPLETE

Contractor


SW SE SW

E/2230
SECTION PLAT

Ft. from N. Line

330 Ft. from S. Line990 Ft. from E. Line

Ft. from W. Line

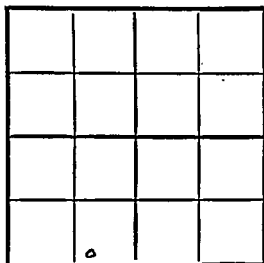

Rooks County

RECORD

Location

Cased _____ in. _____ ft.

Rig up

Sand

Drilling and Remarks:

Gas

Oil

Total Depth

PRODUCTION

1st 24 hrs. Nat.

1st 24 hrs. after shot

Gas _____ Cu. Ft.

Dry Hole

Abandoned

Date

JUN 22 1949

19

S. J. LEWIS

Scout

Art 3795
5-103830
Per Art
3000 acres
Pump 165 oil Port
270 lb