


Section 18 Township 10 Range 19-W

Well No. #5 Anderson

Company Sinclair

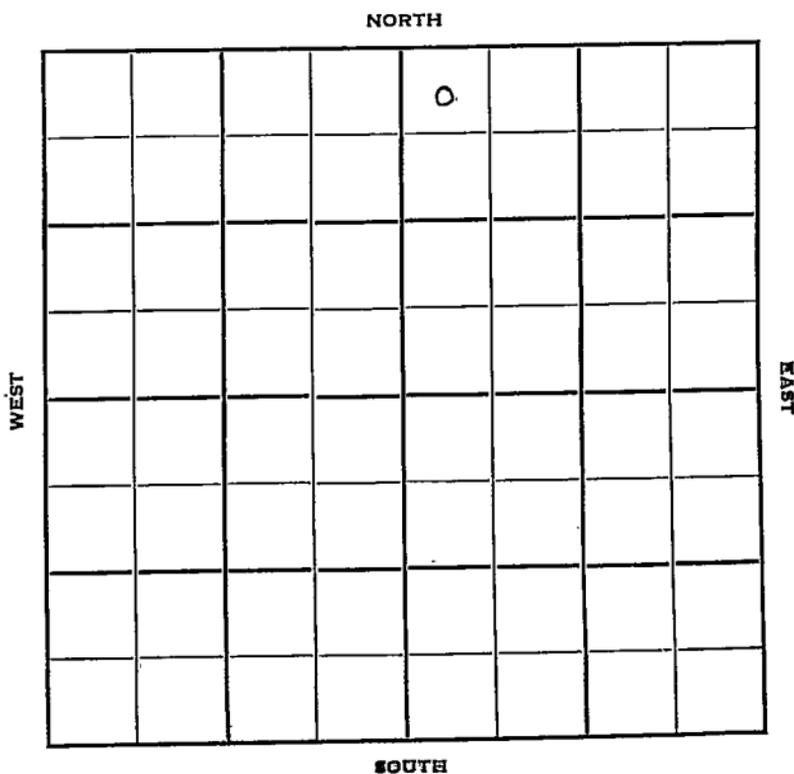

Sec. 18 Twp. 10 R. 19-W ✓

Well No. #5 Anderson Farm
oil and Gas
Sinclair ~~Harbor Drigs~~ Company
Contractor

Berland


330 Ft. from N. Line

Ft. from S. Line

Ft. from E. Line

330 Ft. from W. Line

NW NW NE

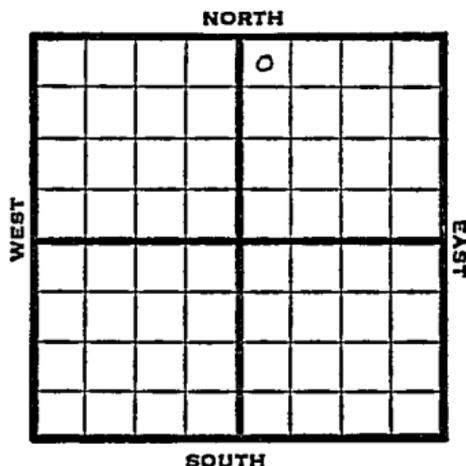

1950 ELEV 2224' REPORT

8/2 Spud 7-30-50
10 3/4" @ 282
WOC
8/30 10 3/4" @ 282
Top 3217 Lans 3463
Cong 3707 Arb 3769-73
7" @ 3767
TD 3773
2000 A
S/2 1/2 boph DD 3786
2000 A
S/25 boph 6 hr
TD 3786
Comp 612 bopd
Completed

COMPLETED

1953 O.W.W.O.

6/24 Lans 3463, Arb 3782.
OTD 3786
7" @ 3768'
PB 3725'
24/ 3667-71 24/ 3653-57 1000 A
S/ 37 boph POP.

OVER

1953

7/1

Oil well TD 3786 Lans 3463
Arb. 3782 OTD 3786 7" @ 3768
PB 3725 -24/3667-71 24/3653-57
1000 A S/37 BOPH
Comp. 63 BOPD

COMPLETED

Kansas

Map No. _____ Sec. 18 Twp. 10 R. 19W

Well No. 5 Anderson

Sinclair Company

Harbar Drlg. Contractor

NW NW NE

330 Ft. from N. Line

_____ Ft. from S. Line

_____ Ft. from E. Line

330 Ft. from W. Line

SECTION PLAT



Rooks County

Location _____

Rig up _____

Drilling and Remarks:

Spud 7-30-50

10 3/4" @ 282

WOC

RECORD

Cased _____ in., _____ ft.

Sand _____

Gas _____

Oil _____

Total Depth _____

PRODUCTION

1st 24 hrs. Nat. _____

1st 24 hrs. after shot _____

Gas _____ Cu. Ft.

Dry Hole _____

Abandoned _____

Date

AUG 2 1950 19

J. E. TYRA

Scout

O.W.W.O.

County Rooks State Kansas

Sec. 18 (Blk. 10 (Sur. 19W (Twp.) 10 (Rge.) 19W Map No.

Operator Sinclair Oil & Gas

Well No. 5 Farm Anderson

Elev. 2224 Location NW NW NE

330 Ft. From N Line NE

330 Ft. From W Line Quarter

1st. Report _____

Completion JUL 1 1953

Remarks O.W.W.O.

O.W.W.O.

Spudding Date _____

Drlg. Data Oil well TD 3786

Lans. 3463 Arb. 3782 OED 3786

7" @ 3768 PB 3725 24/ 3667-71

24/ 3653-57 1000 A S/ 37 boph

Comp. 63 bopd