

DX 78-1

Rooks


KANSAS

Section 18 Township 10 Range 19 W

Well No. # 1 Foulke

Company United Drlg. Co.

NORTH

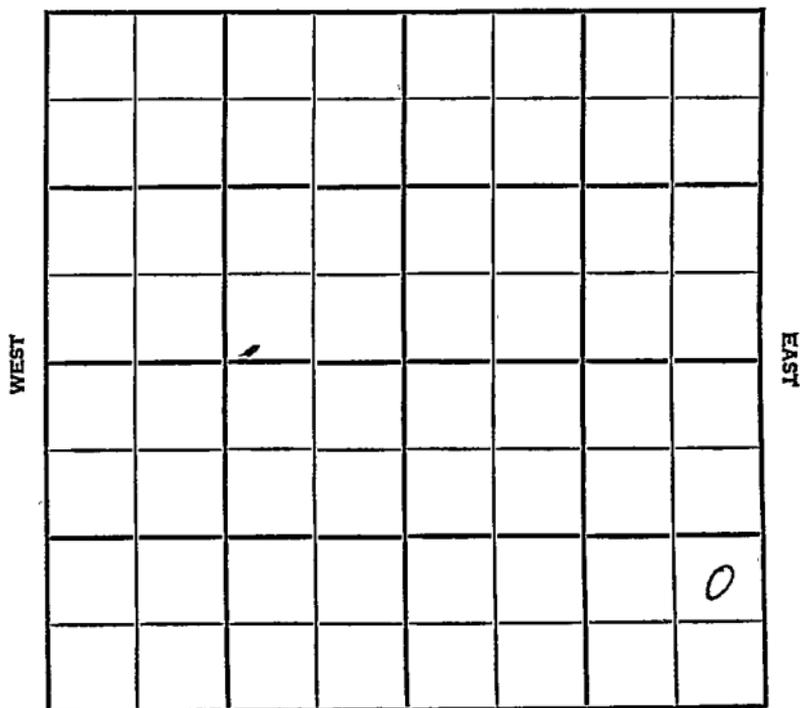

SOUTH

Rooks

KANSAS

SEC.	TWP.	R.
18	10	19 W

WELL NO. # 1 Foulke FARM

COMPANY United Drlg. Co.

CONTRACTOR Co. tools


Wildcat

\_\_\_\_\_ Ft. from N. Line

990 \_\_\_\_\_ Ft. from S. Line

330 \_\_\_\_\_ Ft. from E. Line

\_\_\_\_\_ Ft. from W. Line

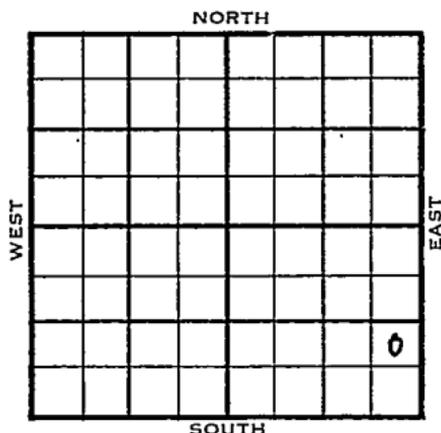

NE SE SE  
Sunray DHM

1954	ELEVATION 2209'	REPORT
------	--------------------	--------

9/22 Spud 9-20-54  
8" @ 183 WOC

11/3 Spud 9-20-54  
Oil Well  
TD 3784'  
8" @ 183'  
Anhy 1625', Top 3209'; Heeb 3420'  
Tor 3442', Lans 3458',  
DST 3592'-3618' opn 1 hr, rec 10' Mud  
O#  
DST 3656'-62' opn 1/2 hr, rec 18' mud  
200# B-KC 3658', Cong 3706', Simp 3744'  
Arb. 3768'  
DST 3769'-78' opn 1 hr, rec 30' Mud  
850#  
DST 3774'-84' opn 1/2 hr, rec 170' ocm  
925#  
TD 3784'  
5 1/2" @ 3784'  
CO to 3780'  
42/ 3772-80 SSO 500 A S/ 4.2 boph  
30 hr.  
Comp 213 bopd.

**COMPLETED**



