


Section 18 Township 10 Range 19 W

Well No. # 8 Marcotte

Company Morris Sitrino (was B & B)

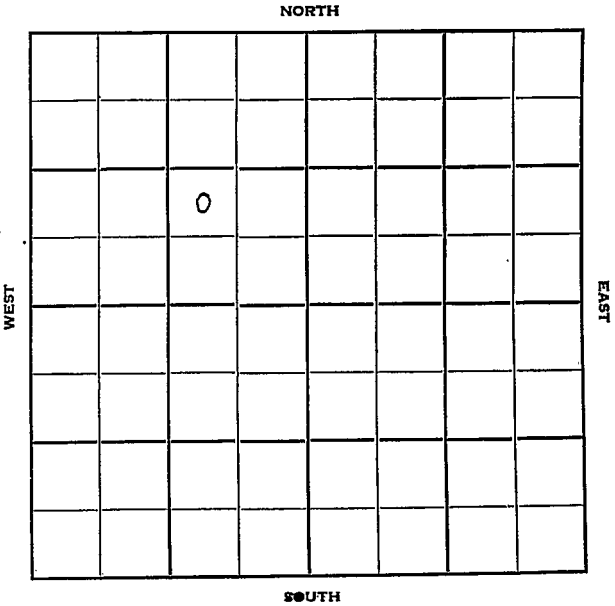

Rooks

KANSAS

Sec. 18 Twp. 10 R. 19W

Well No. #8 Marcotte Farm

Morris Sitrine (was B&B) Company

Murphin - Contr. Contractor

Burland Pool


 Ft. from N. Line

990' Ft. from S. Line

990' Ft. from E. Line

 Ft. from W. Line

NW SE NW

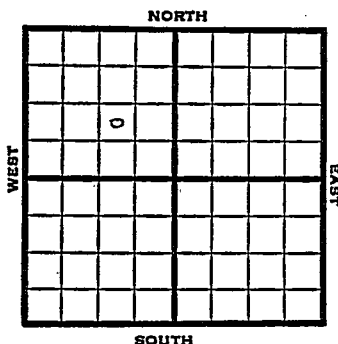

1951 Elev. 2230' REPORT

6/20 Spud 6-16-51
8" @ 178
Drlg. 1661'

8/22 Spud 6-16-51 Oil well TD 3778'
8" @ 178 Heeb 3431' Lans. 3470'
DST 3494-3515' open $\frac{1}{2}$ hr. rec 180' O &
GCM, 285' MCO 80' SW
DST 3548-60 open 20 min. rec 245' SW
DST 3590-3610 open 25 min. rec 80' OCM
Cong. 3706' Simp. 3755' Arb. 3774-
76' 5" @ 3775' TD 3778'
S/22 BOPH 10% water
Comp. 518 BOPD.

COMPLETED

County Rock State Kansas

Sec. 18 (Blk. Twp.) 10 (Sur. Rge.) 19W Map No.

Operator Morris Sitrino ¹ (was - B&B)

Well No. **8** Farm **Marcotte**

Elev.	Location	NW	SE	NW
-------	----------	----	----	----

0
FIRST REPORT

990 Ft. From S Line NW
990 Ft. From E Line Quarter

1st. Report JUN 20 1951

Completion

Remarks


Murphin - Contr.

Spudding Date **6-16-51**

Drig. Data **Burland Pool**

8" @ 178 Drlg. 1661

County _____ Rocks _____ State Kansas
 Sec. 18 (Blk. 10) (Sur. 19W) Map No. _____
 Operator Morris Sitrin (was B & B Drlg.)
 Well No. 8 Farm Marcotte
 Elev. 2230 Location NW SE NW

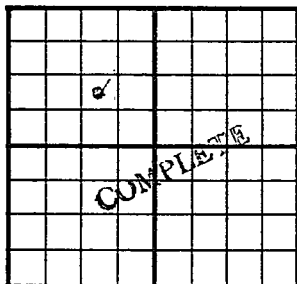

990 Ft. From S Line NW
990 Ft. From E Line Quarter
 1st. Report _____
 Completion AUG 22 1951
 Remarks Berland Pool
Murfin Drlg. - Contr.
 Spudding Date 6-16-51

Drlg. Data Oil well TD 3778
8" @ 178 Heeb. 3431 Lans. 3470
DST 3494-3515 open $\frac{1}{2}$ hr. Rec. 180' o &
gcm 285' mco 80' sw DST 3548-60
open 20 min. Rec. 245' sw DST 3590-3610
open 25 min. Rec. 80' ocm Cong. 3706
Simp. 3755 Arb. 3774-76 5" @ 3775
TD 3778 S/ 22 boph 10% water
Comp. 518 bopd

J. E. TYRA