

KANSAS

FORM 31 2-57 3-49 PETROL

Rooks


~~CARTING~~


Section 18 Township 10 Range 19W

Well No. 3 Marcotte "A"

Company MORRIS STRIN
Birmingham & Bartlett

Berland

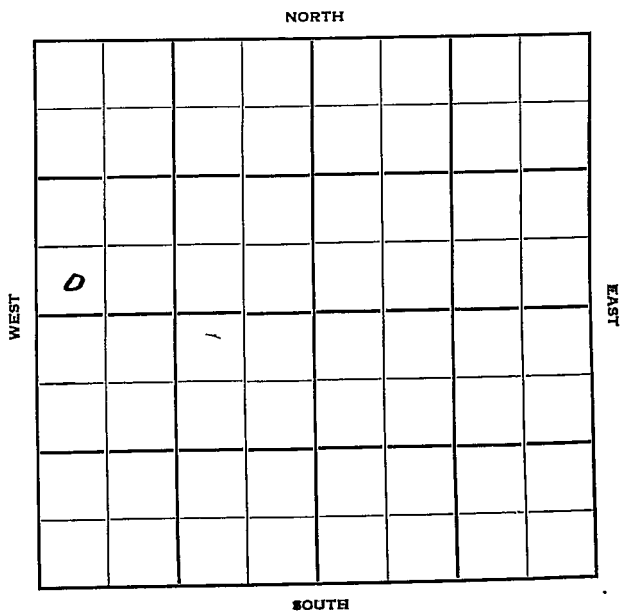

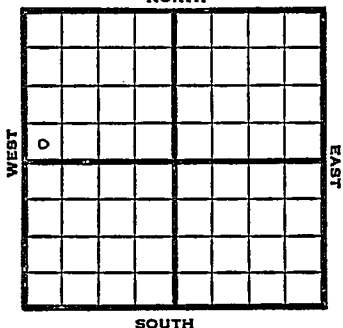Sec. 18 Twp. 10 R. 19WWell No. #3 Marcotte "A" Farm~~MORRIS STRY~~
~~Birmingham & Bartlett~~Berland Pool (Birmingham & Bartlett, Cont.) Company
NORTH Ft. from N. Line330' Ft. from S. Line Ft. from E. Line330' Ft. from W. Line

SW NW

SOUTH

1949	Elev 2229'	REPORT
9/21	8" @ 207'	
9/28	Lansing 3462'	
	Drlg 3494'	
10/5	Arbuckle 3765'-68'	
	TD 3768'	
	5"@ 3768'	
10/12	"	
10/19	"	
10/26	"	
11/1	"	
11/9	TD 3773' wtr PB	
11/16	"	
11/23	TD 3781'	
	Swb 10 bbls fluid PH	
11/29	PB 3750'	
	47 shots 3596-3606	
	1000 acid	
	Swb 50 bbls oil PH	
12/7	TD 3781'	
	Lansing-3462'	
	Arb. 3765'	
	5"@ 3767'	
	Perf Lans.	
	P mp 761 Oil Pot	
	27° Gr.	
	Comp	

COMPLETED

OVER

1952

~~C.W.W.O.~~

~~5/7 To re-acidize~~

Map No. _____ Sec. 18 Twp. 10 R. 19W


Well No. 3 Marcotte "A"

Birmingham & Bartlett Company

Birmingham & Bartlett Contractor

SW NW

FIRST REPORT
SECTION PLAT

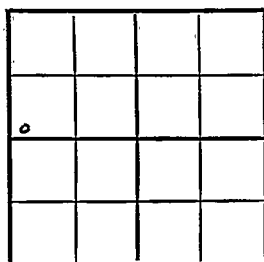

_____ Ft. from N. Line

330 _____ Ft. from S. Line

_____ Ft. from E. Line

330 _____ Ft. from W. Line

Rooks County

Location _____

Rig up _____

Drilling and Remarks:

8" @ 207

RECORD

Cased _____ in., _____ ft.

Sand _____

Gas _____

Oil _____

Total Depth _____

PRODUCTION

1st 24 hrs. Nat. _____

1st 24 hrs. after shot _____

Gas _____ Cu. Ft.

Dry Hole _____

Abandoned _____

Date

SEP 21 1949 19 S. J. LEWIS Scout

Kansas

Map No. _____ Sec. 18 Twp. 10 R. 19W

Well No. 3 Marcotte "A"

Birmingham & Bartlett Company

COMPLETE

Contractor

SW NW


E12229
SECTION PLAT

_____ Ft. from N. Line

330 _____ Ft. from S. Line

_____ Ft. from E. Line

330 _____ Ft. from W. Line

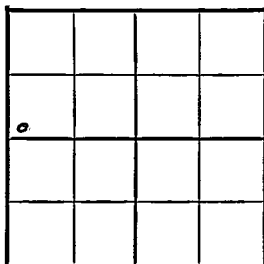

Rooks County

Location _____

Rig up _____

Drilling and Remarks:

Lans 3462

Or Y 3765

5" C 3767

Prof Lans.

Pump 76/ oil Port

27 2/3

RECORD

Cased _____ in., _____ ft.

Sand _____

Gas _____

Oil _____

Total Depth 2787

PRODUCTION

1st 24 hrs. Nat. _____

1st 24 hrs. after shot _____

Gas _____ Cu. Ft.

Dry Hole _____

Abandoned _____

Date _____

DEC 7 1949

19

S. J. LEWIS

Scout

County Rooks State Kansas
 Sec. 18 (Blk. 10 (Sur. 19N Map No. 19N)
 (Twp.) (Rge.)

Operator Morris Sitrin

Well No. 3 Farm Marpette

Elev.	Location	SW	SW	NW
-------	----------	----	----	----

2

FIRST REPORT

330 Ft. From **S** Line **NH**

330 Ft. From N Line Quarter

1st. Report **MAY 7 1952**

Completion.

Remarks **OWHO** 10.0.

Spudding Date _____

Drlg. Data

To re-acidize

J. G. McGEHEE

County _____ Rooks _____ State Kansas
 Sec. 18 (Blk.) 10 (Sur.) 19W Map No. _____
 (Twp.) _____ (Rge.) _____
 Operator Morris Sitrin
 Well No. 3 Farm Marcotte
 Elev. _____ Location SW SW NW

0							

330 Ft. From S Line NW
330 Ft. From W Line Quarter
 1st. Report _____

Completion MAY 14 1952

Remarks _____

OWWO

Spudding Date _____

Drig. Data _____

Incorrect information. Did not work over

J. G. McGEHEE