

Section 18 Township 10 Range 19-W

Well No. #8 Scoggins

Company Skelly
Berland Pool

NORTH

WEST

EAST

0							

SOUTH

Sec. 18 Twp. 10 R. 19W

Well No. #8 Scoggins Farm

Skelly Company

Berland Pool Contractor

NW SW


330' Ft. from N. Line

_____ Ft. from S. Line

_____ Ft. from E. Line

330' Ft. from W. Line

NW SW

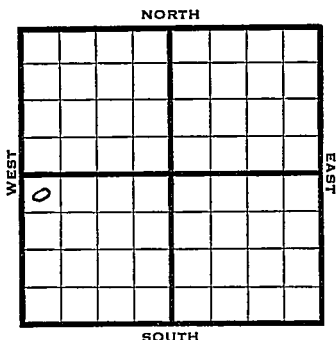

1949 Elev 2229' REPORT

10/26	Location
11/1	8" @ 1642'
	Drig. 1840'
11/9	Lansing 3462'
	Simpson 3754'
	Arbuckle 3767'
11/16	5" @ 3768'
	TD 3770'
	Pump 13 bbls oil / 27 W 10 hrs.
11/23	TD 3783'
	Wtr.
	PB 3773'
11/30	TD 3783'
	Pump 74 bbls oil / 192 W 20 hrs.
12/7	"
12/14	"
12/21	TD 3795'
	60 shots 3598-3604
	1000 acid
	Pump 352 bbls oil 16 hrs.
12/28	"
1950	
1/11	TD 3795'
	8" @ 1642'
	PP 363 BOPD / 10 wtr. from Arb. Lime
	Tops
	Anhy 1628'
	Heb 3426'
	Lan 3462'
	Cg 3698'
	Simp 3754'
	Arb. 3767'
	Comp

COMPLETED

Kansas

Berland Pool

Map No. _____ Sec. 18 Twp. 10 R. 19W

Well No. 8 Scoggins

Skelly _____ Company

Contractor

NW SW

FIRST REPORT
SECTION PLAT

330 Ft. from N. Line

_____ Ft. from S. Line

_____ Ft. from E. Line

330 Ft. from W. Line

o			

Rooks County

Location X

Rig up _____

Drilling and Remarks:

RECORD

Cased _____ in., _____ ft.

Sand _____

Gas _____

Oil _____

Total Depth _____

PRODUCTION

1st 24 hrs. Nat. _____

1st 24 hrs. after shot _____

Gas _____ Cu. Ft.

Dry Hole _____

Abandoned _____

Date

OCT 26 1949

19

S. J. LEWIS

Scout

Map No. _____ Sec. 18 Twp. 10 R. 19WWell No. 8 Scoggins_____
Skelly _____ Company


Contractor

NW SW

Elev. 2229
SECTION PLAT330 Ft. from N. Line

____ Ft. from S. Line

____ Ft. from E. Line

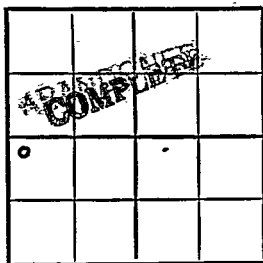330 Ft. from W. Line

Rooks County

RECORD

Location _____

Rig up _____

Drilling and Remarks:

*8" @ 1642**PP363 BOPD!**+ 10 wtr from
Arbuckle lime.**(Tops - Over)*

Cased _____ in., _____ ft.

Sand _____

Gas _____

Oil _____

Total Depth ~~3788~~ 3795

PRODUCTION

1st 24 hrs. Nat. _____

1st 24 hrs. after shot _____

Gas _____ Cu. Ft.

Dry Hole _____

Abandoned _____

Date

JAN 11 1950 19J. E. TYRA Scout

Arch 1628
Feb 3426
Jan 3462
Cg. 3698
Simp 3754
Arch 3767

JAN 16 1950

Scout Cards	<i>Scout</i>
Land Small Map	
Land Wall Map	3
Tracings	
France Map	
Pierce Map	
Misc.	