


Section 18 Township 10 Range 19W

Well No. #11 Scoggins

Company Skelly

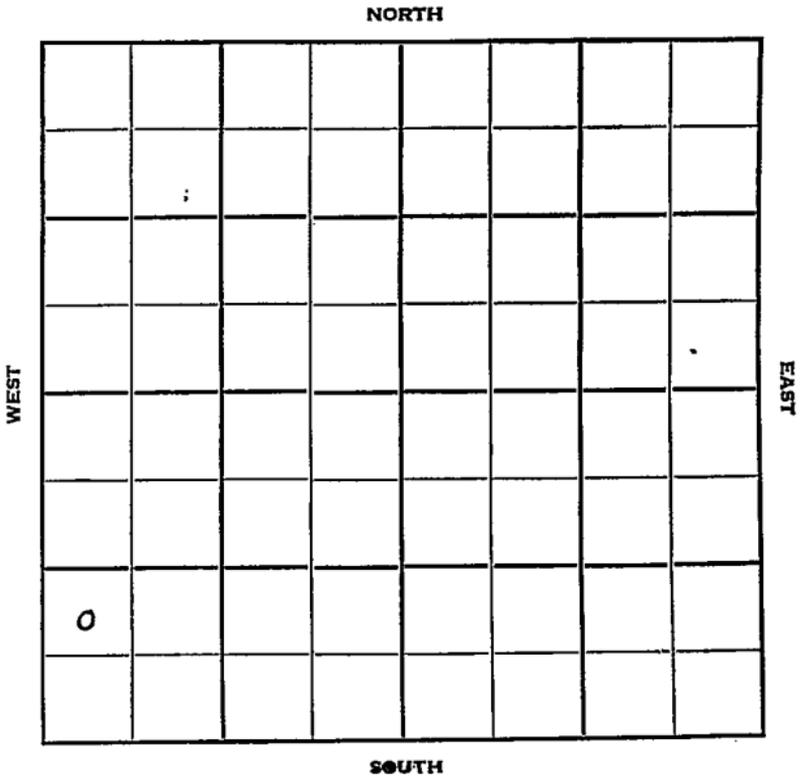

Sec. 18 Twp. 10 R. 19W

Well No. #11 Scoggins Farm _____

Skelly Company _____

Contractor _____

Berland Pool


_____ Ft. from N. Line

990' Ft. from S. Line

_____ Ft. from E. Line

330' Ft. from W. Line

NW SW SW

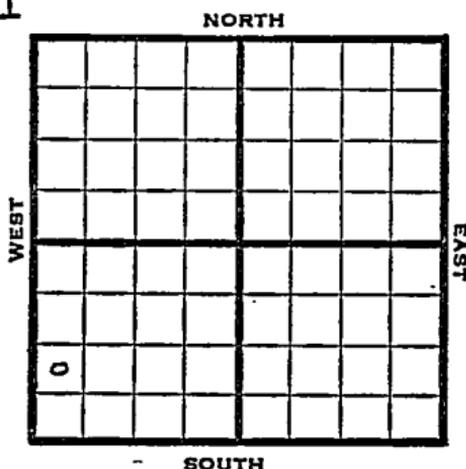

1950 Elev. 2227' REPORT

12/6 Location

1951

1/17 Spud 12-7-50
 Oil Well TD 3765
 Anhy 1619' 8" @ 1629
 Top 3240' Heeb. 3420 Lans. 3457
 Cong. 3699' Simp. 3750
 Arb. 3763-65 5 1/2" @ 3764
 45/3666-71 1000 A S/50 bo 4 hr
 SP 3660 36/3651-55 1000 A S/64 bo
 4 hr SP 3628 27/3603-09 27/3595-98
 1000 A S/60 bo 4 hr SP 3585
 45/3575-80 1000 A S/86 bo 3 hr
 SP 3568 36/3562-66 36/3555-59
 81/3544-53 S/20 bo 64 bw 16 hr
 36/3495-99 54/3500-06 1000 A
 S/64 bo 4 bw 2 1/2 hr DP 3730 4500 A
 Comp. 976 bopd 28% wtr.

COMPLETED

