

5-10-18W

STATE CORPORATION COMMISSION OF KANSAS
OIL & GAS CONSERVATION DIVISIONWELL COMPLETION OR RECOMPLETION FORM
ACO-1 WELL HISTORY

DESCRIPTION OF WELL AND LEASE

Operator: License # 5068
 Name Black Petroleum Co.
 Address 527 Union Center Building
 City/State/Zip Wichita, Kansas 67202

Purchaser.....

Operator Contact Person Thomas E. Black
 Phone 316-264-9342

Contractor: License # 5302
 Name Red Tiger Drilling Company

Wellsite Geologist.....
 Phone.....

Designate Type of Completion

☒ New Well ☐ Re-Entry ☐ Workover

☐ Oil ☐ SWD ☐ Temp Abd
☐ Gas ☐ Inj ☐ Delayed Comp.
☒ Dry ☐ Other (Core, Water Supply etc.)

If OWWO: old well info as follows:

Operator
 Well Name
 Comp. Date Old Total Depth.....

WELL HISTORY

Drilling Method:

☒ Mud Rotary ☐ Air Rotary ☐ Cable

3/5/86 3/12/86 3/13/86
 Spud Date Date Reached TD Completion Date
 3,787'
 Total Depth PBTD

Amount of Surface Pipe Set and Cemented at 279.35 feet
 Multiple Stage Cementing Collar Used? ☐ Yes ☐ No
 If yes, show depth set.....feet
 If alternate 2 completion, cement circulated
 from.....feet depth to.....w/.....SX cmt

API NO. 15-163-22,875

County Rooks

NE/4 SE/4 SW/4 5 10S 18W ☐ East
 Sec..... Twp..... Rge..... ☒ West

990 Ft North from Southeast Corner of Section
 2970 Ft West from Southeast Corner of Section
 (Note: Locate well in section plat below)


Lease Name Hilgers Well # 1

Field Name.....

Producing Formation.....

Elevation: Ground.....KB.....

Section Plat

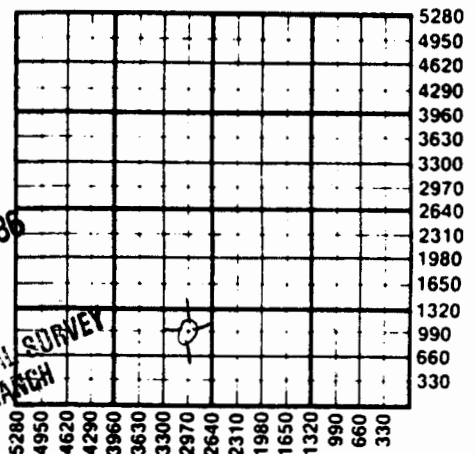

WATER SUPPLY INFORMATION

Disposition of Produced Water: ☐ Disposal
 Docket # ☐ Repressuring

Questions on this portion of the ACO-1 call:

Water Resources Board (913) 296-3717

Source of Water:

Division of Water Resources Permit #.....

☐ Groundwater.....Ft North from Southeast Corner
 (Well)Ft West from Southeast Corner of
 Sec Twp Rge ☐ East ☐ West

☒ Surface Water 700 Ft North from Southeast Corner
 (Stream, pond, etc.) 4800 Ft West from Southeast Corner
 Sec 17 Twp 10S Rge 18 ☐ East ☒ West

John Dauwe, Plainville, Ks. 67663

☐ Other (explain).....
 (purchased from city, R.W.D. #)

INSTRUCTIONS: This form shall be completed in duplicate and filed with the Kansas Corporation Commission, 200 Colorado Derby Building, Wichita, Kansas 67202, within 90 days after completion or recompletion of any well. Rule 82-3-130 and 82-3-107 apply.

Information on side two of this form will be held confidential for a period of 12 months if requested in writing and submitted with the form. See rule 82-3-107 for confidentiality in excess of 12 months.

One copy of all wireline logs and drillers time log shall be attached with this form. Submit CP-4 form with all plugged wells. Submit CP-111 form with all temporarily abandoned wells.

W81-01-3

72358

SIDE TWO

Operator Name Black Petroleum Company Lease Name..... Hilgers Well #..... 1

Sec..... 5 Twp..... 10S Rge..... 13W ☐ East
☒ West County..... Rooks

WELL LOG

INSTRUCTIONS: Show important tops and base of formations penetrated. Detail all cores. Report all drill stem tests giving interval tested, time tool open and closed, flowing and shut-in pressures, whether shut-in pressure reached static level, hydrostatic pressures, bottom hole temperature, fluid recovery, and flow rates if gas to surface during test. Attach extra sheet if more space is needed. Attach copy of log.

.....

Drill Stem Tests Taken ☐ Yes ☐ No
 Samples Sent to Geological Survey ☐ Yes ☐ No
 Cores Taken ☐ Yes ☐ No

Formation Description
☐ Log ☐ Sample

Name Top Bottom

CASING RECORD ☒ New ☐ Used							
Report all strings set-conductor, surface, intermediate, production, etc.							
Purpose of String	Size Hole Drilled	Size Casing Set (in O.D.)	Weight Lbs/Ft.	Setting Depth	Type of Cement	#Sacks Used	Type and Percent Additives
Surface	12 1/4"	8 5/8"	20#	287.35'	60/40 Poz	180	2% Gel 3%CC

PERFORATION RECORD		Acid, Fracture, Shot, Cement Squeeze Record (Amount and Kind of Material Used)	
Shots Per Foot	Specify Footage of Each Interval Perforated		Depth

TUBING RECORD				Liner Run ☐ Yes ☐ No	
Size	Set At	Packer at			

Date of First Production Producing Method ☐ Electric ☐ Surging ☐ Gas Lift ☐ Other (explain)