

9-10-18W

STATE CORPORATION COMMISSION OF KANSAS  
OIL & GAS CONSERVATION DIVISION  
WELL COMPLETION OR RECOMPLETION FORM  
ACO-1 WELL HISTORY  
DESCRIPTION OF WELL AND LEASE

Operator: License # KCC 4673  
Name O.R.M. Exploration Co.  
Address 2600 Continental Plaza  
777 Main St.  
City/State/Zip Ft. Worth, TX 76102

Purchaser

Operator Contact Person Amy Johnston  
Phone (817) 336-4827

Contractor: License # unknown  
Name Red Tiger Drilling

Wellsite Geologist Danny Moxley  
Phone (303) 733-5734

Designate Type of Completion

New Well  Re-Entry  Workover  
 Oil  SWD  Temp Abd  
 Gas  Inj  Delayed Comp.  
 Dry  Other (Core, Water Supply etc.)

If ONWO: old well info as follows:

Operator  
Well Name  
Comp. Date  
Old Total Depth

WELL HISTORY

Drilling Method:

Mud Rotary  Air Rotary  Cable

12-27-85 01/01/86  
Spud Date Date Reached TD Completion Date

3800' P & A: 01/03/86  
Total Depth PBTD

Amount of Surface Pipe Set and Cemented at 256 feet  
Multiple Stage Cementing Collar Used? Yes No  
If yes, show depth set feet  
If alternate 2 completion, cement circulated from feet depth to w/ SX cmt  
Cement Company Name  
Invoice #

API NO. 15-1163-02-850  
County Rooks  
Sec 9 Twp 10 Rge 18 East  
West

670 Ft North from Southeast Corner of Section  
4290 Ft West from Southeast Corner of Section  
(Note: Locate well in section plat below)

Lease Name Sutar Well #


Field Name

Producing Formation

Elevation: Ground 2162 KB 2167

Section Plat

NOV 30 1986  
KANSAS GEOLOGICAL SURVEY  
WICHITA BRANCH

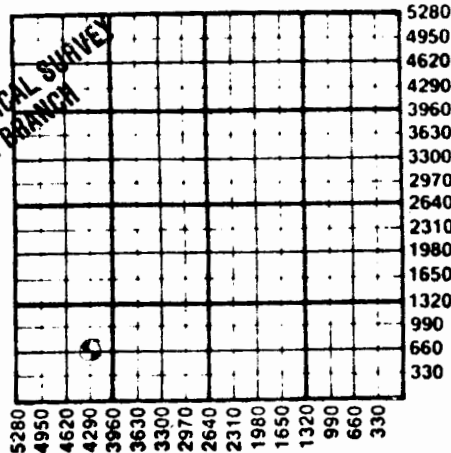

WATER SUPPLY INFORMATION

Disposition of Produced Water: Disposal  
Docket # Repressuring

Questions on this portion of the ACO-1 call:  
Water Resources Board (913) 296-3717

Source of Water:  
Division of Water Resources Permit #

Groundwater Ft North from Southeast Corner  
(Well) Ft West from Southeast Corner of  
Sec Twp Rge East West

Surface Water Ft North from Southeast Corner  
(Stream, pond etc) Ft West from Southeast Corner  
Sec Twp Rge East West

Other (explain)  
(purchased from city, R.W.D. #)

INSTRUCTIONS: This form shall be completed in duplicate and filed with the Kansas Corporation Commission, 200 Colorado Derby Building, Wichita, Kansas 67202, within 90 days after completion or recompletion of any well. Rule 82-3-130 and 82-3-107 apply.

Information on side two of this form will be held confidential for a period of 12 months if requested in writing and submitted with the form. See rule 82-3-107 for confidentiality in excess of 12 months. One copy of all wireline logs and drillers time log shall be attached with this form. Submit CP-4 form with all plugged wells. Submit CP-111 form with all temporarily abandoned wells.

Operator Name O.R.M. Exploration Corp. Lease Name Sutor Well # 1

Sec 9 Twp 10 Rge 18  East  West County Rooks

WELL LOG

INSTRUCTIONS: Show important tops and base of formations penetrated. Detail all cores. Report all drill stem tests giving interval tested, time tool open and closed, flowing and shut-in pressures, whether shut-in pressure reached static level, hydrostatic pressures, bottom hole temperature, fluid recovery, and flow rates if gas to surface during test. Attach extra sheet if more space is needed. Attach copy of log.

Drill Stem Tests Taken  Yes  No  
 Samples Sent to Geological Survey  Yes  No  
 Cores Taken  Yes  No

Formation Description  
 Log  Sample

Name	Top	Bottom
Lansing/KC	3391	
Toronto	3369	
Arbuckle	3727	

NOV 3 11  
 KANSAS GEOLOGICAL SURVEY  
 WICHITA BRANCH

CASING RECORD <input type="checkbox"/> New <input type="checkbox"/> Used Report all strings set-conductor, surface, intermediate, production, etc.							
Purpose of String	Size Hole Drilled	Size Casing Set (in O.D.)	Weight Lbs/Ft.	Setting Depth	Type of Cement	#Sacks Used	Type and Percent Additives
SURFACE	7 7/8	8 5/8	24	250	CLASS C	200	6% GEL 2-KC
PERFORATION RECORD				Acid, Fracture, Shot, Cement Squeeze Record			
Shots Per Foot	Specify Footage of Each Interval Perforated			(Amount and Kind of Material Used)		Depth	
TUBING RECORD				Liner Run <input type="checkbox"/> Yes <input type="checkbox"/> No			
Date of First Production		Producing Method		<input type="checkbox"/> Flowing <input type="checkbox"/> Pumping <input type="checkbox"/> Gas Lift <input type="checkbox"/> Other (explain).....			