


KANSAS CORPORATION COMMISSION

WELL RECORD

29-10-18W

(Mail to Kansas Geological Survey, 4150 Monroe Street, Wichita, Kansas 67209)

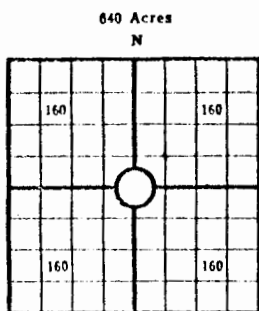

Locate well correctly

Lease Name: Dauwe Well No. 1
Well Located: Rooks County, Kansas
NE SE NE SEC 29 TWP 10S RGE 18W
Operator: Beacon Resources Corporation
Address: 1000 Century Plaza, Wichita, Ks. 67202
Elevation: Ground D.F. K.B. 2096
Type Well: (Oil, gas, dry hole) D&A

API-15-163-20,413

Drilling Commenced: Jan. 1 1972 Drilling Completed: Jan. 10 1972
Well Completed: 19 Total Depth 3720
Initial Production: _____

Casing Record

Size: 8-5/8 Set at 248' Size: _____ Set at _____
Size: _____ Set at _____ Size: _____ Set at _____

Liner Record

Size: None Set from _____ To _____

Cementing

<u>Casing Size</u>	<u>Sacks</u>	<u>Type Cement and Additives</u>
<u>8-5/8"</u>	<u>175</u>	<u>SS Common</u>
_____	_____	_____
_____	_____	_____

Perforations

<u>Formation</u>	<u>Perforated Interval and Number Shots</u>
<u>None</u>	_____
_____	_____
_____	_____
_____	_____

Electric Log Run (Show type log and depths covered)

Radiation-guard to 3715'

(Fill in formation and related information on reverse side)

cont.

FORMATION, TESTING AND COMPLETION RECORD

29-10-18w

Show Drill Stem Tests,
Well Stimulation and
Production Tests

Formation Top Bottom

DST #1 3247-3286 30-30-30-30 Rec. 310'
VHOCM 370' OCSW 1019# - 53# - 173# -
215# - 280# 990# T-100°

DST #2 (TOR) 3284-3320 (30-30-30-30)
Rec. 20' mud. 239# - 59# FP 23 - 30
T-102°

DST #3 3348-3380 30-30-30-30 45' WM.
1047 - 784 48# - 56# 102°

DST #4 3376-3400 30 - 30-30-30 Rec. 20' mud.
FP 48 - 48# BHP 232 - 96# T-102°

DST #5 3450-3515 30-30-30-30 45' SOCM
60' mud. BHP 1055# - 784# FP 80# - 104#

DST #6 3515-3560 30-30-30-30 10' OSM
BHP 232# - 112# FP 56# - 56# 103°

Anhy. 1436
Hb. 3285
Tor. 3308
Lsg. 3333
Arb. 3704
LTD 3715
RTD 3720



507205

DREILING OIL, INC.

Victoria, Kansas 67671

KANSAS GEOLOGICAL SURVEY
503 EAST 10TH AVENUE
WICHITA, KANSAS 67202

WELL LOG

29-10-18W

Company **Bacon Resources Corporation**
1000 Century plaza
Wichita, Kansas 67202
Farm **Dauwe** No. 1
Total Depth **3,720'**
Comm. **1-1-72** Comp. **1-10-72**
Contractor **Dreiling Oil, Inc.**
Victoria, Kansas 67671

Sec. 29 Twp. 10 Rng. 18
Location NE SE NE
County Rooks
Elevation: 2096 K. B.
2093 D. F.
2091 G. R.

Casing Record
284' - 8 5/8"

Cement Record
175 sacks cement

Production: **D & A**

Figures Indicate Bottom of Formations

0'	40'	Surf. Soil-P. Rock
40'	150'	Shale
150'	248'	Shale
248'	898'	Shale
898'	950'	Shale
950'	1148'	Sand
1148'	1440'	Red Bed
1440'	1476'	Anhydrite
1476'	1790'	Shale
1790'	1900'	Shale & Lime Streaks
1900'	2230'	Shale & Lime Streaks
2230'	2460'	Lime & Shale
2460'	2615'	Lime & Shale
2615'	2725'	Lime & Shale
2725'	2925'	Lime w/streaks-Shale
2925'	3070'	Lime & Shale
3070'	3100'	Lime
3100'	3235'	Lime
3235'	3286'	Lime
3286'	3310'	Lime
3310'	3320'	Lime LOG TOPS DEPTH
3320'	3380'	Lime ANHY 1436
3380'	3400'	Lime HEEB 3285
3400'	3420'	Lime TOR 3308
3420'	3495'	Lime LKC 3333
3495'	3515'	Lime ARB 3704
3515'	3560'	Lime LTD 3715
3560'	3565'	Lime RTD 3720
3565'	3648'	Lime
3648'	3677'	Chert
3677'	3720'	Chert
3720'	T.D.	Chert

STATE OF KANSAS)
)ss
COUNTY OF ELLIS)

I, Leo F. Dreiling, of Dreiling Oil, Inc., upon oath states that