Rooks

FORM 51 10M 12-46 PETROL


KANSAS

Section 19 Township 10 Range 18W

Well No. 1 Wise

Company Cities Service et al

Wildcat

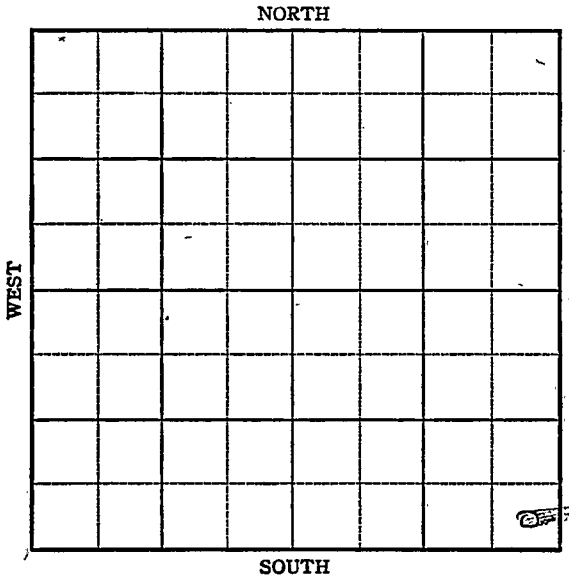

16

FORM 252-A-
5M 12-46 PETROL


KANSAS Rooks

Sec. 19 Twp. 10 R. 18-W

Well No. #1 Wise Farm

Cities Service etal Company

Wildcat

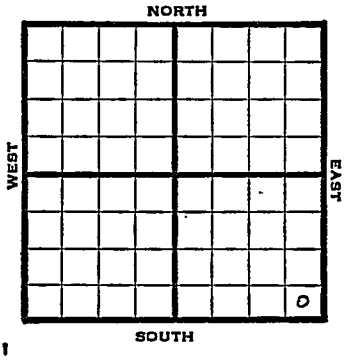

____ Ft. from N. Line

330 Ft. from S. Line

330 Ft. from E. Line

____ Ft. from W. Line

SE/C Elev. 2074'

1947	REPORT
3/19	RUR
3/25	8" @ 240' Drlg 3070'
4/2	Lans 3320' Arb. 3667'.

ABANDONED

Form 26 200 Bks. 10-46 Petrol. KANSAS Kansas Wildcat

Map No. 64 Sec. 19 Twp. 10 R. 18W

Well No. 1 Wise


Cities Service etal. Company

FIRST REPORT

Contractor

SE/C

SECTION PLAT

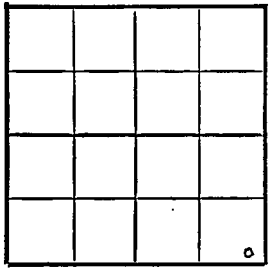

____ Ft. from N. Line

330 Ft. from S. Line

330 Ft. from E. Line

____ Ft. from W. Line

Rooks County

Location

Rig up

Drilling and Remarks:

R U R

RECORD

Cased ____ in., ____ ft.

Sand

Gas

Oil

Total Depth

PRODUCTION

1st 24 hrs. Nat.

1st 24 hrs. after shot

Gas ____ Cu. Ft.

Dry Hole

Abandoned

Date

MAR 1 9 1947 19

S. J. LEWIS Scout

Form 26 200 Bks. 10-46 Petrol

Wildcat

Kansas

Map No. K64 Sec. 19 Twp. 10 R. 18W

Well No. 1 Wise


Cities Service etal. Company

ABANDONED Contractor

SE/C

E1.2074

SECTION PLAT

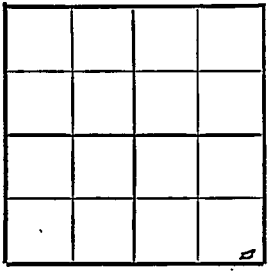

____ Ft. from N. Line

330 Ft. from S. Line

330 Ft. from E. Line

____ Ft. from W. Line

Rooks County

Location

Rig up

Drilling and Remarks:

Lans 3328

CI X8667

RECORD

Cased ____ in., ____ ft.

Sand

Gas

Oil

Total Depth 3746

PRODUCTION

1st 24 hrs. Nat.

1st 24 hrs. after shot

Gas ____ Cu. Ft.

Dry Hole

Abandoned

Date

APR 2 1947 19

S. J. LEWIS Scout