

KANSAS

Rooks

Section 19 Township 10 Range 19WWell No. 1 BerlandCompany Petroleum Inc.**Berland**

NORTH

				Q			

WEST

EAST

SOUTH

Rooks ✓

Sec. 19 Twp. 10 R. 19W

Well No. #1 Berland Farm _____

Petroleum, Inc. Company _____


Berland Pool

330' Ft. from N. Line

_____ Ft. from S. Line

_____ Ft. from E. Line

330' Ft. from W. Line

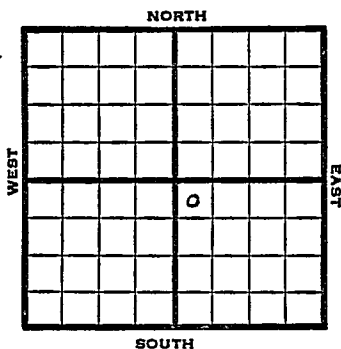

NW SE

1949

REPORT

2/16	Location
2/23	8"@ 197'
	Drlg 2350'
3/2	Lansing 3486'
	Drlg 3586'
3/8	Arbuckle 3805'
	TD 3811
	5"@ 3807'
3/15	"
3/23	250 acid
	Swb 29 bbls oil & 21 W in 12 hrs.
3/30	"
4/6	"
4/12	"
4/20	"
4/27	"
5/4	"
5/10	"
5/18	"
5/25	"
6/1	"
6/7	"
6/15	Lans 3486'
	Arb 3805'
	5"@ 3807'
	TDn3811
	Perf Lans
	1000 acid
	Aband.

ABANDONED

Kansas

Berland Pool

Map No. _____ Sec. 19 Twp. 10 R. 19W

Well No. 1 Berland

Petroleum Inc.

Company

FIRST REPORT

Contractor

NW SE

SECTION PLAT

330 Ft. from N. Line

Ft. from S. Line

Ft. from E. Line

330 Ft. from W. Line

		6	

Rooks County

Location X

Rig up

Drilling and Remarks:

RECORD

Cased _____ in., _____ ft.

Sand _____

Gas _____

Oil _____

Total Depth _____

PRODUCTION

1st 24 hrs. Nat. _____

1st 24 hrs. after shot _____

Gas _____ Cu. Ft.

Dry Hole _____

Abandoned _____

Date

FEB 16 1949 19

S. J. LEWIS

Scout

Rooks County Kansas State
 Map No. 165 Sec. 19 Twp. 10 R. 19W

Well No. 1 Berland

Petroleum Inc.

Company

ABANDONED

Contractor

NW SE

E. 2229
 SECTION PLAT

330

Ft. from N. Line

Ft. from S. Line

Ft. from E. Line

330

Ft. from W. Line

				0			

Berland Pool

Remarks:

Line 3486

Qr 3885

5" @ 3802

WD 3811

Prof. Name.

1000 acid

Date

Scout

JUN 15 1949