FORM 51 10M 8-47


KANSAS

Rooks

Section 19 Township 10 Range 19W

Well No. #2 Berland

Company Texas

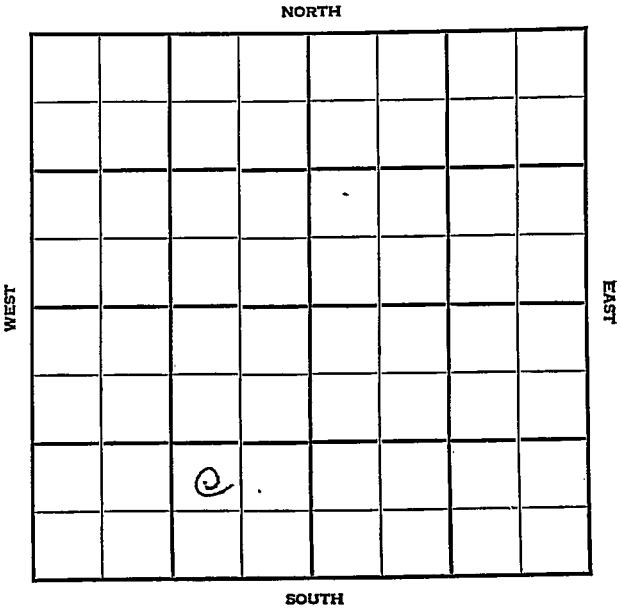

FORM 252-A
5M 4-48 PETROL

KANSAS Rooks

Sec. 19 Twp. 10 R. 19W

Well No. #2 Berland Farm

Texas Company

Berland Pool


990' Ft. from N. Line

Ft. from S. Line

990' Ft. from E. Line

Ft. from W. Line

SW NE SW

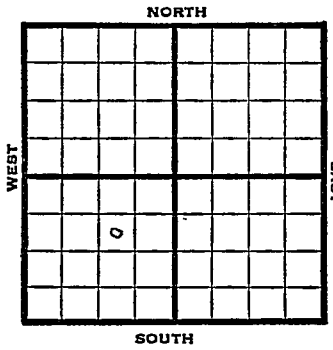

1948	REPORT Elev. 2213'
5/26	Location
6/1	8" @ 1608' WOC
6/9	Lansing 3462' Drlg 3510'
6/16	TD 3785' 5" @ 3783' Arbuckle 3782'
6/23	Swb 23 bbls oil 1 hr SW
6/29	Pump 216 bbls oil & 167 W 24 hrs.
7/8	Arbuckle 3782' 5" @ 3783' Pump 216 oil & 167 W Pot. Gr. 29° TD 3785' COMPLETED

Form 26—200 Bks.—1-48—Palace

Berland Pool

Kansas

Map No. _____ Sec. 19 Twp. 10 R. 19W

Well No. 2 Berland

Texas Company

FIRST REPORT

Contractor

SW NE SW


990 Ft. from N. Line

_____ Ft. from S. Line

990 Ft. from E. Line

_____ Ft. from W. Line

SECTION PLAT

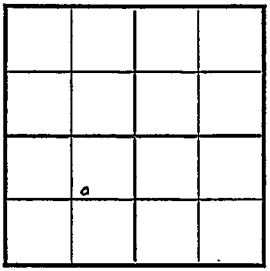

Rooks County

Location x

Rig up

Drilling and Remarks:

RECORD

Cased _____ in., _____ ft.

Sand

Gas

Oil

Total Depth

PRODUCTION

1st 24 hrs. Nat.

1st 24 hrs. after shot

Gas _____ Cu. Ft.

Dry Hole

Abandoned

Date

MAY 26 1948 19

S. J. LEWIS Scout

Form 26—200 Bks.—1-48—Palace

Berland Pool

Kansas

Map No. 65 Sec. 19 Twp. 10 R. 19W

Well No. 2 Berland


Texas Company

COMPLETE Contractor

SW NE SW

E/2213

SECTION PLAT

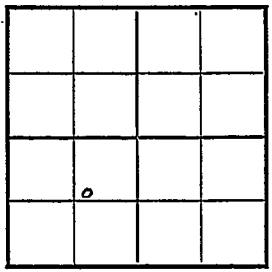

990 Ft. from N. Line

Ft. from S. Line

990 Ft. from E. Line

Ft. from W. Line

Rooks County

Location

Rig up

Drilling and Remarks:

CR 3782

5" @ 3783

Pump 216 oil + 16 BW 8 hrs

29 - 6

RECORD

Cased in., ft.

Sand

Gas

Oil

Total Depth 3785

PRODUCTION

1st 24 hrs. Nat.

1st 24 hrs. after shot

Gas Cu. Ft.

Dry Hole

Abandoned

Date

JUL 8 1948 19 S. J. LEWIS Scout