


KANSAS · Rooks

Section 19 Township 10 Range 19W

Well No. 5 Berland

Company Texas

Berland Pool
NORTH

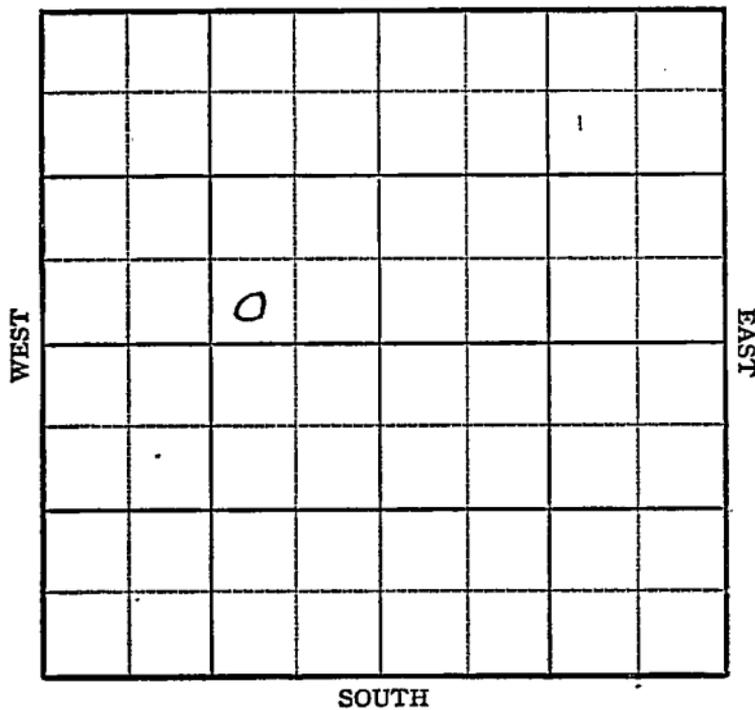

SOUTH

KANSAS

Rooks



Sec. 19 Twp. 10 R. 19W

Well No. #5 Berland Farm

Texas

Company

Berland Pool

Ft. from N. Line

330'


Ft. from S. Line

990'

Ft. from E. Line

Ft. from W. Line

SW SE NW

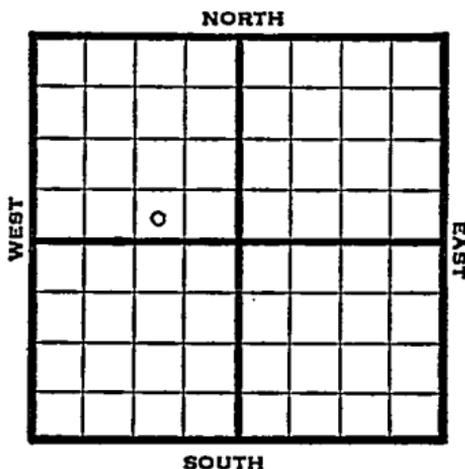

1948

Elev. 2226' REPORT

9/8 Drlg. 740'

9/14 8" @ 1621'

Drlg 2965'

9/21 Lansing 3478'

Arb 3791' = 95'

TD 3795'

Run csg.

9/29 5" @ 3792 5000 acid

Swb 5 oil PH 6 hrs.

10/6 TD 3797'

Swb 4 bbls oil PH

10/13 Arb 3791'

5" @ 3792'

Pump 365 oil & 10W Pot.

TD 3797'

COMPLETED

Rooks County Kansas State
 Map No. _____ Sec. 19 Twp. 10 R. 19W
 Well No. 5 Berland
Texas Company

FIRST REPORT

Contractor

SW SE NW

SECTION PLAT

_____ Ft. from N. Line

330 Ft. from S. Line990 Ft. from E. Line

_____ Ft. from W. Line

Berland Pool

Remarks:

drlg. 740

Date
SEP 8 1948

Scout S. J. LEWIS

