

Well No. 15 Berland

Company Texas

Berland
NORTH

WEST

0

EAST

SOUTH

Rooks

KANSAS ✓

Sec. 19 Twp. 10 R. 19W

Well No. #15 Berland Farm _____
Texas _____ Company _____

Berland Pool

330'

_____ Ft. from N. Line


_____ Ft. from S. Line

_____ Ft. from E. Line

330'

_____ Ft. from W. Line

NW/C

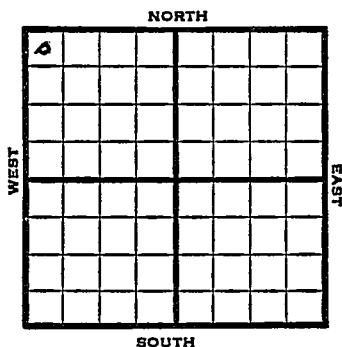

1949

Elev. 2217' REPORT

8/3

Location

8/10

"

8/17

8" @ 1618'

Drlg 2230'

8/24

Eamsing 3456.

Arbuckle 3761

TD 3766 SO. Run csg.

8/31

5" @ 3761'

900' oil

9/7

Arb 3761'

5" @ 3761'

Depth Pot. 3000 oil

TD 3766'

Grav. 28°

TD 3766'

COMPLETED

Kansas

Berland Pool

Map No. _____ Sec. 19 Twp. 10 R. 19WWell No. 15 Berland

Texas

Company _____


Contractor _____

NW/C

FIRST REPORT
SECTION PLAT330 Ft. from N. Line

_____ Ft. from S. Line

_____ Ft. from E. Line

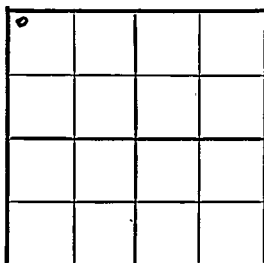330 Ft. from W. Line

Rooks County

Location ✓

Rig up _____

Drilling and Remarks: _____

RECORD

Cased _____ in., _____ ft.

Sand _____

Gas _____

Oil _____

Total Depth _____

PRODUCTION

1st 24 hrs. Nat. _____

1st 24 hrs. after shot _____

Gas _____ Cu. Ft.

Dry Hole _____

Abandoned _____

Date

AUG 3 1949 19 S. J. LEWIS Scout

Map No. K65 Sec. 19 Twp. 10 R. 19W

Well No. 15 Berland

Texas

Company

COMPLETE

Contractor

NW/4

E1.2217
SECTION PLAT

0			

330 Ft. from N. Line

Ft. from S. Line

Ft. from E. Line

330 Ft. from W. Line

Rooks County

Location

Rig up

Drilling and Remarks:

Per 83761

5" @ 3761.

Del. H. B. 83800

28 1/2

RECORD

Cased in., ft.

Sand

Gas

Oil

Total Depth 3766

PRODUCTION

1st 24 hrs. Nat.

1st 24 hrs. after shot

Gas Cu. Ft.

Dry Hole

Abandoned

Date

SEP 7 1949 19

S. J. LEWIS Scout