





Sec. 19 Twp. 10 R. 19W

Well No. #4 Berland Farm

Texas

Company

Berland Pool


330' Ft. from N. Line

Ft. from S. Line

330' Ft. from E. Line

Ft. from W. Line

NE SW

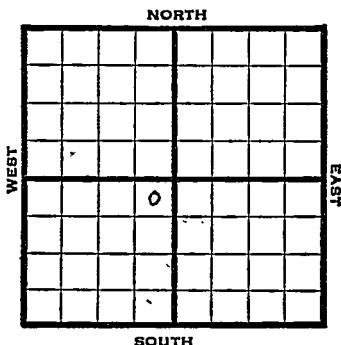

1948

Elev. 2230' REPORT

8/18

Drlg. 1060'

8/25

8" @ 1625'  
Drlg 2880'

9/1

Drlg. 3594'

9/8

Lansing 3479'  
Arbuckle 3804-07'  
TD 3807'  
5" @ 3805'

9/14

800 acid  
Swb 147 bbls oil / 6 W 12 hrs.

9/22

Arb 3804'  
5" @ 3805'  
TD 3807'  
800 acid  
Pump 299 oil & 117 W Pot.  
Gr. 28°

**COMPLETED**



