

Section 19 Township 10 Range 19W

Well No. 10 Berland

Company Texas

Berland Pool
NORTH

WEST	0						EAST

SOUTH

KANSAS

Rooks

Sec. 19 Twp. 10 R. 19W ✓

Well No. #10 Berland Farm

Texas

Company

Berland Pool


_____ Ft. from N. Line

330' Ft. from S. Line

_____ Ft. from E. Line

330' Ft. from W. Line

SW NW

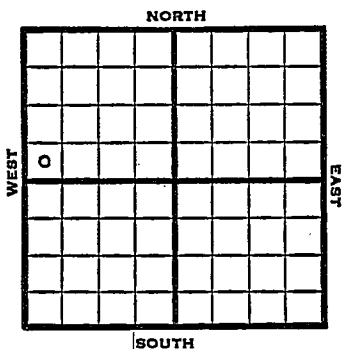

1948 Elev. 2225' REPORT

12/29 Location

1/5 ~~8" @ 1623'~~
Drlg. 2395'

1/12 Lansing 3476 Arbuckle 3784-87TD
Rng Csg

1/19 5" @ 3785' 500 acid
Swb 85 bbls oil 17 hrs.
500 acid

1/26 Arb. 3784'
5" @ 3785'
1000 acid
Pump 211 oil & 1½ W Pot.
Gr. 28°
TD 3787'

COMPLETED

Map No. _____ Sec. 19 Twp. 10 R. 19W

Well No. 10 Berland

Texas Company

FIRST REPORT Contractor

SW NW

SECTION PLAT

_____ Ft. from N. Line

330 Ft. from S. Line

_____ Ft. from E. Line

330 Ft. from W. Line

Rooks County

Location X

Rig up _____

Drilling and Remarks: _____

RECORD

Cased _____ in., _____ ft.

Sand _____

Gas _____

Oil _____

Total Depth _____

PRODUCTION

1st 24 hrs. Nat. _____

1st 24 hrs. after shot _____

Gas _____ Cu. Ft.

Dry Hole _____

Abandoned _____

Date

DEC 29 1948 19

S. J. LEWIS Scout

