


Rooks

KANSAS

SECTION 19 TOWNSHIP 10 RANGE 20 WWELL NO. #1 GaedeCOMPANY C & G Drlg. & OIL Trading

NORTH

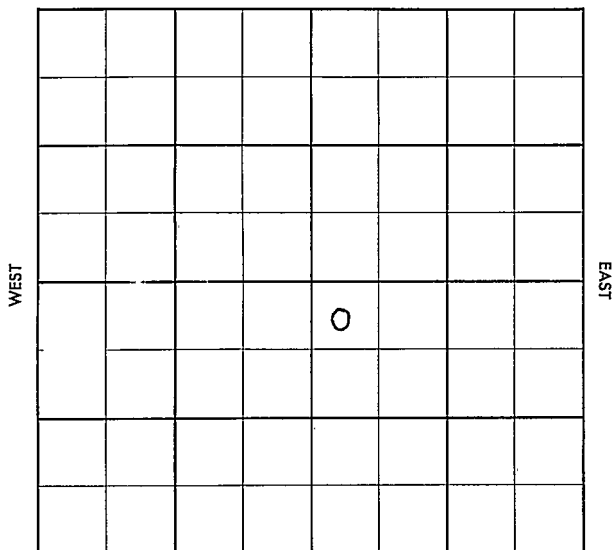

SOUTH

Rooks

KANSAS

SEC.	TWP.	R..
19	10	20 W

WELL NO.

1 Gaede

FARM

COMPANY

C & G Drlg. & Oil Trading

CONTRACTOR

Co. tools


Wildcat

_____ Ft. from N. Line

_____ Ft. from S. Line

_____ Ft. from E. Line

_____ Ft. from W. Line

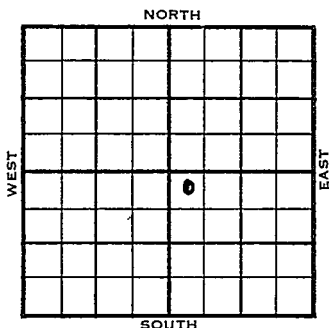

NW NW SE

SDX - 1/2 Mile

	ELEVATION	REPORT
1955	2101'	
11/9	Comm. 11-4-55 8" @ 189/150 Drlg. 2700'	
11-16	D&A Tops: Tp. 3154 H. 3365 Tr. 3384 L. 3401 B.K.C 3625 C. 3694 A. 3742 TD 3762'	

ABANDONED

County Rooks Elev. 2101
 Sec. 19 Twp. 10 Rge. 20W
 Company C & G Drilling & Oil Trading
 FarmName Gaede No. 1

TOPS	DEPTH	LOG	DATUM	Loc. in Sec.
Anh.				NW NW SE
Tr.				
H.				
Tr.				
Dg.				
BL.				
L.				Geol.
K.C.				Contr.
B.K.C.				Co. tools
Ce.				
C.				Pool
M.				Wildcat
M.				
K.				
Mz.				
Mq.				
V.				
S.				
S.				
A.				
R.				
Pe.				
G.				
T.D.				

Date Comm. 11-4-55
8" @ 189/150 drlg. 2700

NOV 9 '55
 FIRST REPORT
 0
 1/2 mile

County Books Elev. 2101
 Sec. 19 Twp. 1 Rge. 20W
 Company C & G Drilling & Oil Trading
 Farm Name Gaede No. 1

TOPS	DEPTH	LOG	DATUM	Loc. in Sec.
Anb.				
Tp.	<u>3154</u>		<u>1053</u>	NW NW SE
H.	<u>3365</u>		<u>1264</u>	
Tr.	<u>3384</u>		<u>1283</u>	
Dg.				
Bl.				
L.	<u>3401</u>		<u>1300</u>	Geol.
K.C.				Contr.
B.K.C.	<u>3625</u>		<u>1524</u>	Co. tools
Ce.				Pool
C.	<u>3694</u>		<u>1593</u>	Wildcat.
M.				
M.				
K.				
Mz.				
Mq.				
V.				
S.				
S.				
A	<u>3742</u>		<u>1641</u>	
R.				
PE				
G.				
T.D.	<u>3762</u>			

Date Comm. 11-4-55 NOV 16 1955
 8" @ 189/150

D & A