

Section 19 Township 10 Range 20WWell No. #1 HinkhouseCompany C & G Drlg.

Wildcat

NORTH

							Q

WEST

EAST

SOUTH

Rooks



Sec. 19 Twp. 10 R. 20W

Well No. #1 Hinkhouse Farm

C & G Drlg. Company

Wildcat (C & G Drlg., Contr.)


 Ft. from N. Line

330' Ft. from S. Line

330' Ft. from E. Line

 Ft. from W. Line

SE NE

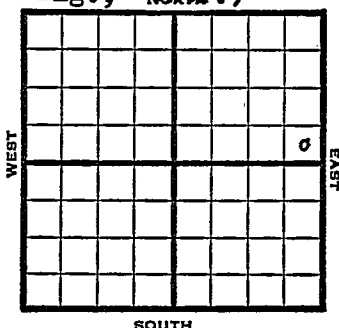

1949	Elev 2103'	REPORT
12/7	Location	
12/14	"	
12/21	"	
12/28	8"@ 220'	
	Drlg 1450'	
1950		
1/11	TD 3787'	
	8"@ 220'	
	Heb 3361'	
	Tor 3379'	
	Lan 3399'	
	Cg 3683'	
	Arb. 3758'	
	No shows.	
	D&A	
	Aband.	
	ABANDONED	

Map No. _____ Sec. 19 Twp. 10 R. 20W

Well No. 1 Hinkhouse

C & G Drlg. _____ Company

C & G Drlg. _____ Contractor

SE NE

**FIRST REPORT
SECTION PLAT**

_____ Ft. from N. Line

330 Ft. from S. Line

330 Ft. from E. Line

_____ Ft. from W. Line

			o

Rooks County

Location X

Rig up _____

Drilling and Remarks:

RECORD

Cased _____ in., _____ ft.

Sand _____

Gas _____

Oil _____

Total Depth _____

PRODUCTION

1st 24 hrs. Nat. _____

1st 24 hrs. after shot _____

Gas _____ Cu. Ft.

Dry Hole _____

Abandoned _____

Date

DEC 7 1949 19

S. J. LEWIS Scout

Kansas

Wildcat

Map No. _____ Sec. 19 Twp. 10 R. 20WWell No. 1 Hinkhouse

C & G Drlg.

Company _____

Contractor _____


SE NE

Elev. 2103
SECTION PLAT.

_____ Ft. from N. Line

330 Ft. from S. Line330 Ft. from E. Line

_____ Ft. from W. Line

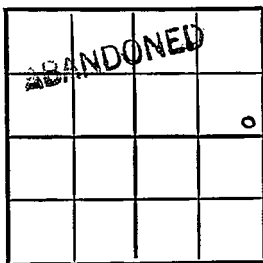

Rooks County

RECORD

Location _____

Cased _____ in., _____ ft.

Rig up _____

Sand _____

Drilling and Remarks:

Gas _____

Oil _____

Total Depth 3787

PRODUCTION

1st 24 hrs. Nat. _____

1st 24 hrs. after shot _____

Gas _____ Cu. Ft.

Dry Hole _____

Abandoned ☒

Date

JAN 11 1959

J. E. TYRA

Scout