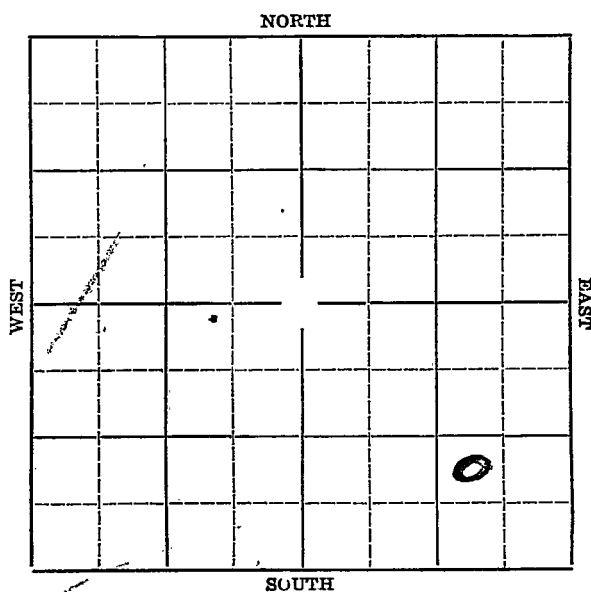


Section 19 Township 10 Range 21WWell Number #1 HillsCompany Noah & Young.


Map No. KANSAS Sec. 19 Twp. 10 R. 21WWell No. #1 Hills FarmNoah & Young Company

Ft. from N. Line

990' Ft. from S. Line990' Ft. from E. Line

Ft. from W. Line

Elev. 2255

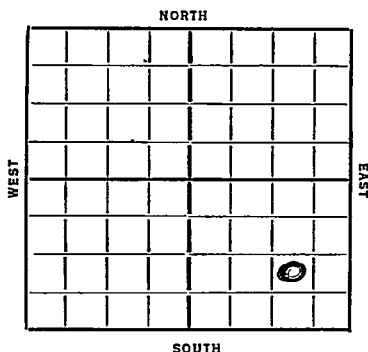

Date	REPORT
1936	
5/27	Rig & tools. Cable.
6/4--	6/11--6/18--6/25--7/2 --7/9--
7/16	--7/23--7/30--
8/6	Rigging up.
8/13	Spud.
8/20	Drlg. 740'.
8/27	15" @ 920'. Drlg. 1010'.
9/3	13" @ 1168'. Drlg. 1295'.
9/10	T.D. repair engine.
9/18	Drlg. 1573'.
9/24	Anhydrate 1770'. 10" @ 1772'.
	Drlg. 1960'.
10/1	No report.
10/8	8" @ 2825'. TD 3144'. Underream 8".
10/15	8" @ 3144'. Drlg. 3317'.
10/22	8" @ 3291'. Drlg. 3365'.
10/29	7" @ 3508'. Drlg. 3528'.
11/6	Kansas City 3533 Drlg. 3654
11/12	7" @ 3664'.
	Drlg. 3802'.
	OVER

1936

11/18--Sil. 3923 T. D. 3974
H.F.W. 3959 D & A

ABANDONED

Map No. 65 Sec. 19 Twp. 10 R. 21 WWell No. 1 HillsNoah Young CompanyNoah Young Contractor

SECTION PLAT

			0

 Ft. from N. Line990 Ft. from S. Line990 Ft. from E. Line Ft. from W. Line

FIRST REPORT

Location Rig up

Drilling and Remarks:

Rig & tools
Chase

RECORD

Cased in., ft.Sand Gas Oil Total Depth

PRODUCTION

1st 24 hrs. Nat. 1st 24 hrs. after shot Gas Cu. Ft.Dry Hole Abandoned

Date

13. 1936

19

S. J. Lewis Scout

KANSAS

Map No. 65 Sec. 19 Twp. 10 R. 21W.Well No. 1 H. 16.Noah & Young. CompanyNoah & Young. Contractor

SECTION PLAT

			o

 Ft. from N. Line990 Ft. from S. Line990 Ft. from E. Line Ft. from W. Line

ABANDONED

Location Rig up

Drilling and Remarks:

Oil 3923NW. 3959DA

RECORD

Cased in., ft.Sand Gas Oil Total Depth 3974

PRODUCTION

1st 24 hrs. Nat. 1st 24 hrs. after shot Gas Cu. Ft.Dry Hole Abandoned

Date

NOV 18 1936 19S. J. LEWIS Scout