


WELL LOG BUREAU KANSAS GEOLOGICAL SOCIETY
 412 Union National Bk. Bldg., Wichita, Kansas

15-103-03488

Company - DARBY & BOTHWELL, INC.
 Farm - Vohs "B" No. 1

SEC. 14 T. 10 R. 19W
 SW SE SE

Total Depth. 3575'
 Comm. 11-6-47 Comp. 12-8-47
 Shot or Treated. Acidized
 Contractor.
 Issued. 1-17-48

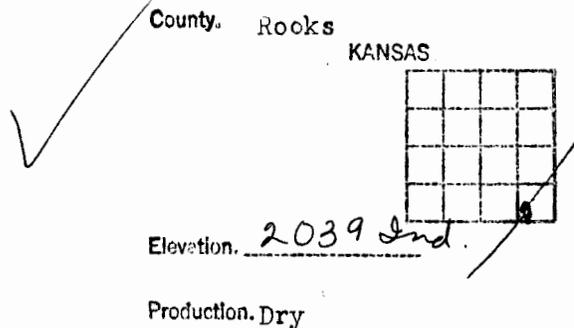

Figures Indicate Bottom of Formations.

surface clay	65
shale & sand	180
shale	310
shale sand & shells	535
shale & shells	760
shale	790
shells & shale	825
shale & lime	900
sand	1085
shale lime & sand	1140
shale & shells	1210
shale & red rock	1260
sand & red rock	1315
red rock	1408
anhydrite	1440
red rock shale & shells	1770
shale & shells	1800
salt & shale	1915
shale & lime	2125
shaly lime & shale	2255
shale & lime	2622
lime	2700
shale & lime	3085
lime	3489
conglomerate	3505
shale & sand	3569
dolomite	3575

Total Depth

TOPS:

Anhydrite	1408
Heebner	3200
Lansing	3242
Conglomerate	3480
Krbuckle	3569

Perforate 50 shots	3404-12
36 "	3268-80
33 "	3254-64
3 "	3281-84

All perforations acidized & tested
 2 B. F. P. H. 50% water. D & A.