

STATE CORPORATION COMMISSION OF KANSAS
OIL & GAS CONSERVATION DIVISION

WELL COMPLETION OR RECOMPLETION FORM
ACO-1 WELL HISTORY

CONFIDENTIAL

DESCRIPTION OF WELL AND LEASE

Operator: License # 6033
Name Murfin Drilling Company
Address 250 N. Water
Suite 300
City/State/Zip Wichita, Ks. 67202

Purchaser Clear Creek, Inc.
McPherson, KS

Operator Contact Person L.O. Butner
Phone 316-267-3241

Contractor: License # 6033
Name Murfin Drilling Company

Wellsite Geologist Roger Welty
Phone 913-674-5835

Designate Type of Completion

- New Well Re-Entry Workover
- Oil SWD Temp Abd
- Gas Inj Delayed Comp.
- Dry Other (Core, Water Supply etc.)

If OWMO: old well info as follows:

Operator
Well Name
Comp. Date Old Total Depth.....

WELL HISTORY

Drilling Method:

- Mud Rotary Air Rotary Cable

8/20/85	8/30/85	9/13/85
Spud Date	Date Reached TD	Completion Date
3870'	3837'	
Total Depth	PBTD	

Amount of Surface Pipe Set and Cemented at.....feet
 Multiple Stage Cementing Collar Used? Yes No
 If yes, show depth set.....feet
 If alternate 2 completion, cement circulated
 from...1647...feet depth to...surf...w/400...SX cmt

API NO. 15-.....163-22,748 **19-10-19 W**

County.....Rooks

.....SE 1/4 19 10S 19W East
.....Sec.....Twp.....Rge..... West

1600' Ft North from Southeast Corner of Section

750' Ft West from Southeast Corner of Section

(Note: Locate well in section plat below)


Lease Name.....H. Berland Well #.....1-19

Field Name.....Wildcat

Producing Formation.....Arbuckle

Elevation: Ground.....2210.....KB.....2215

Section Plat

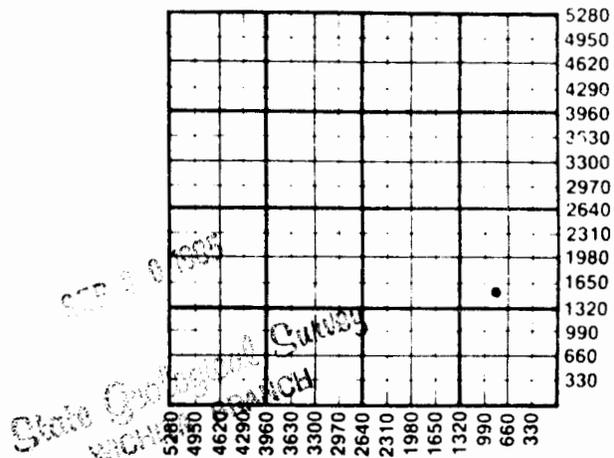

WATER SUPPLY INFORMATION

Disposition of Produced Water: Disposal
 Docket # Repressuring

Questions on this portion of the ACO-1 call:
Water Resources Board (913) 296-3717

Source of Water:

Division of Water Resources Permit #.....

Groundwater.....Ft North from Southeast Corner
 (Well)Ft West from Southeast Corner of
 Sec Twp Rge East West

Surface Water.....Ft North from Southeast Corner
 (Stream, pond etc).....Ft West from Southeast Corner
 Sec Twp Rge East West

Other (explain).....
 (purchased from city, R.W.D. #)

INSTRUCTIONS: This form shall be completed in duplicate and filed with the Kansas Corporation Commission, 200 Colorado Derby Building, Wichita, Kansas 67202, within 90 days after completion or recompletion of any well. Rule 82-3-130 and 82-3-107 apply.

Information on side two of this form will be held confidential for a period of 12 months if requested in writing and submitted with the form. See rule 82-3-107 for confidentiality in excess of 12 months.

One copy of all wireline logs and drillers time log shall be attached with this form. Submit CP-4 form with all plugged wells. Submit CP-111 form with all temporarily abandoned wells.