

STATE CORPORATION COMMISSION OF KANSAS
OIL & GAS CONSERVATION DIVISION
WELL COMPLETION OR RECOMPLETION FORM
ACO-1 WELL HISTORY
DESCRIPTION OF WELL AND LEASE

API NO. 15-...163-23,002
County...Rooks
SE/4 19 10S 19 East
..... Sec. Twp. Rge. X West

19-10-19W

2nd

Operator: License # 6033
Name MURFIN DRILLING COMPANY
Address 250 North Water
Suite 300
City/State/Zip Wichita, KS, 67202

1090 Ft North from Southeast Corner of Section
330 Ft West from Southeast Corner of Section
(Note: Locate well in section plat below)

Purchaser Clear Creek, Inc.
McPherson, KS

Lease Name HENRY BERLAND Well # 3-19

Field Name Marcotte


Producing Formation Arbuckle

Operator Contact Person Larry M. Jack
Phone 267-3241

Elevation: Ground 2191 GL 2197 KB

Contractor: License # 6033
Name Murfin Drilling Company

Wellsite Geologist Rich Bell
Phone 913-674-2528

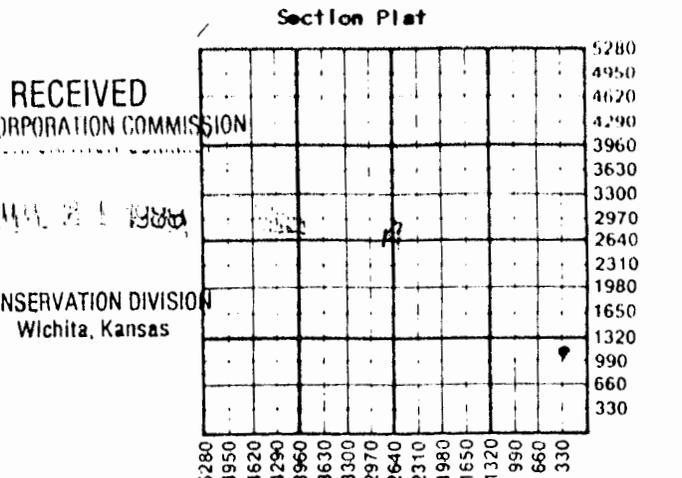

Designate Type of Completion
X New Well Re-Entry Workover
X Oil SWD Temp Abd
Gas Inj Delayed Comp.
Dry Other (Core, Water Supply etc.)

If ONWO: old well info as follows:
Operator
Well Name
Comp. Date Old Total Depth

WATER SUPPLY INFORMATION
Disposition of Produced Water: X Disposal
Docket # D23824 Repressuring

WELL HISTORY

Drilling Method: X Mud Rotary Air Rotary Cable
6-10-88 6-18-88 7-11-88
Spud Date Date Reached TD Completion Date
3850' 3823'
Total Depth PBTD 8-5/8" @ 231
Amount of Surface Pipe Set and Cemented at...feet
Multiple Stage Cementing Collar Used? X Yes No
If yes, show depth set 1617 feet
If alternate 2 completion, cement circulated from 1617 feet depth to surf w/ 400 SX cmt
Cement Company Name
Invoice #

Questions on this portion of the ACO-1 call:
Water Resources Board (913) 296-3717
Source of Water:
Division of Water Resources Permit #
Groundwater...Ft North from Southeast Corner
(Well) ...Ft West from Southeast Corner of
Sec Twp Rge East West
Surface Water...Ft North from Southeast Corner
(Stream, pond etc)...Ft West from Southeast Corner
Sec Twp Rge East West
X Other (explain) Water Hauled
(purchased from city, R.W.D. #)

INSTRUCTIONS: This form shall be completed in triplicate and filed with the Kansas Corporation Commission, 200 Colorado-Derby Building, Wichita, Kansas 67202, within 120 days of the spud date of any well. Rule 82-3-130, 82-3-107 and 82-3-106 apply. Information on side two of this form will be held confidential for a period of 12 months if requested in writing and submitted with the form. See rule 82-3-107 for confidentiality in excess of 12 months. One copy of all wireline logs and drillers time log shall be attached with this form. Submit CP-4 form with all plugged wells. Submit CP-111 form with all temporarily abandoned wells.

All requirements of the statutes, rules and regulations promulgated to regulate the oil and gas industry have been fully complied with and the statements herein are complete and correct to the best of my knowledge.

Signature By: Larry M. Jack
Production Manager
Title Date 7/19/88

K.C.C. OFFICE USE ONLY
E Letter of Confidentiality Attached
C Wireline Log Received
C Drillers Timelog Received
Distribution
KCC SWD/Rep NGPA
X KGS Plug Other
(Specify)

Subscribed and sworn to before me this 19 day of July
19 88
Notary Public Kerran Redington
Date Commission Expires 2/6/90

KERRAN REDINGTON
NOTARY PUBLIC
STATE OF KANSAS
My App. Exp.

JUL 27 1988
KANSAS GEOLOGICAL SURVEY
WICHITA BRANCH

Sec. 19, Twp. 10, Rge. 19