

Section 2 Township 10 Range 16 W

Well No. # 1 Pfortwiller

Company Strain Drlg. & Sargent

NORTH

							o

/

WEST

EAST

SOUTH

Rooks KANSAS

Sec. 2 Twp. 10 R. 16 W

Well No. # 1 Pfortwiller Farm

Strain Drlg. & Sargent Company

Strain Drlg. Contractor


Wildcat
330 Ft. from N. Line

_____ Ft. from S. Line

330 Ft. from E. Line

_____ Ft. from W. Line

NE NE NE

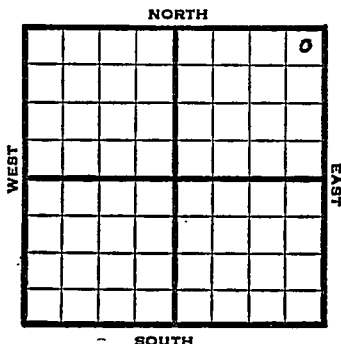

1951 Elev. 2011' REPORT

2/28 Anhy 1180' Heeb 3124'
Dodge 3147' Lans 3170'
Drlg. 3432'

3/7 Spud 2-19-51
D&A TD 3609
Anhy 1180 Heeb. 3124
Dodge 3147 Lans. 3170
Arb. 3559- TD 3609
D&A

ABANDONED

