

KANSAS
~~KANSAS~~


Rooks

Section 2 Township 10 Range 16W

Well No. 1 Pfortwiller

Company B & R Drlg.

Wildcat
NORTH

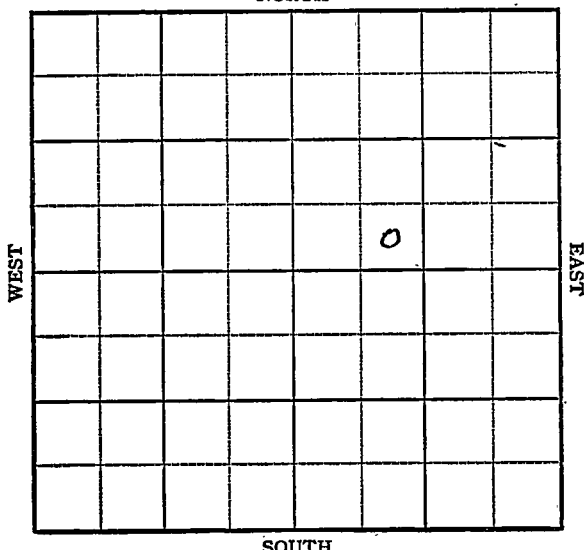

Sec. 2 Twp. 10 R. 16W

Well No. 1 Pfortwiller Farm

B & R Drlg. Company


Wildcat

 Ft. from N. Line

330 Ft. from S. Line

 Ft. from E. Line

990 Ft. from W. Line

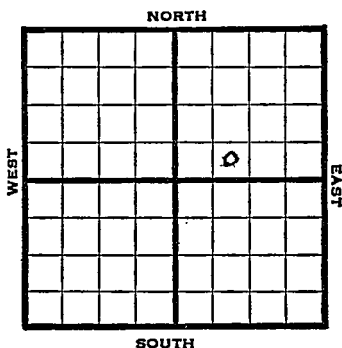

1948

Eli 1988'

R E P O R T

9/22

RUR

9/29

8"@ 78'

Lansing 3133'

Drlg 3315'

10/6

Arb. 3487'

5"@ 3383'

TD 3503'

24 shots 3334-42

23 shots 3287-95 500 acid

10/13

2500 acid

no help

24 shots 3266-72

10/19

2000 acid

10/26

"

11/3

"

11/10

TD 3502'

Arb. 3487'

5"@ 3383'

Aband.

ABANDONED

Rooks County Kansas State

Map No. _____ Sec. 2 Twp. 10 R. 16W

Well No. 1 Pfortwiller

B & R Drlg. Company

FIRST REPORT Contractor

SE SW NE

SECTION PLAT

_____ Ft. from N. Line

330 Ft. from S. Line

_____ Ft. from E. Line

990 Ft. from W. Line

Wildcat

Remarks:

R U R

Scout **S. J. LEWIS**

Date
SEP 22 1948

MAILED

Map No. 64 Sec. 2 Twp. 10 R. 16WWell No. 1 PfortwillerB & R Drlg.

Company


ABANDONED

Contractor

SE SW NE

E 11 1988

SECTION PLAT

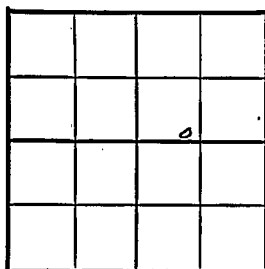 Ft. from N. Line330 Ft. from S. Line Ft. from E. Line990 Ft. from W. Line

Rooks County

Location Rig up

Drilling and Remarks:

CR 34875" C 3383

RECORD

Cased in., ft.Sand Gas Oil Total Depth 3502

PRODUCTION

1st 24 hrs. Nat. 1st 24 hrs. after shot Gas Cu. Ft. Dry Hole Abandoned

Date

NOV 10 1948

19

S. J. LEWIS

Scout