

KANSAS

Section 2 Township 10 Range 17-W

Well No. #1 Ekey

Company Phillips & Hanson

NORTH

							0

8

WEST

EAST

SOUTH

Rooks
10

KANSAS
17W

Sec. 2 Twp. _____ R. _____

Well No. #1 Ekey Farm _____

Phillips & Hanson Company _____

Wildcat Contractor _____


_____ Ft. from N. Line

330' Ft. from S. Line

330' Ft. from E. Line

_____ Ft. from W. Line

SE SE NE

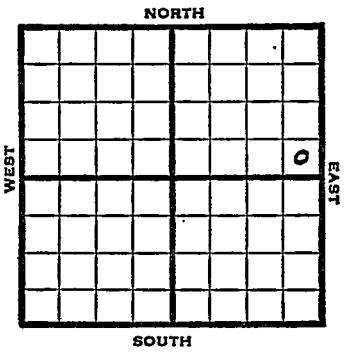

1950

Elev 2061

REPORT

8/16

Location

8/30

Spud 8-16-50

8" @ 184

Anhy 1288 Top 2989

Stain 3132-40 Heeb 3169

Toronto 3189 Lans 3211

Cong 3496 Simp 3512

Arb 3535-75 TD

TD 3575

D&A

ABANDONED

County _____ Rocks _____ State Kansas

Sec. 2 (Blk. Twp.) 10 (Sur. Rge.) 17W Map No. _____

Operator Phillips & Hanson

Well No. 1 Farm Ekey

Elev. 2061 Location SE SE NE

ABANDONED

330 Ft. From S Line NE

330 Ft. From E Line Quarter

Ist. Report

Completion AUG 30 1950

Remarks

Wildcat

Spudding Date 8-16-50

Drlg. Data D & A TD 3575

8" @ 184 Anhy. 1288 Top. 2989

Stain 3132-40 Heeb. 3169 Toronto 3189

Lans. 3211 Cong. 3496 Simp. 3512

Arb. 3535-75 TD D & A

J. E. TYRA