


Section 2 Township 10 Range 17 WWell No. # 1 LoregCompany Anschutz, Flourney & Hastin

NORTH

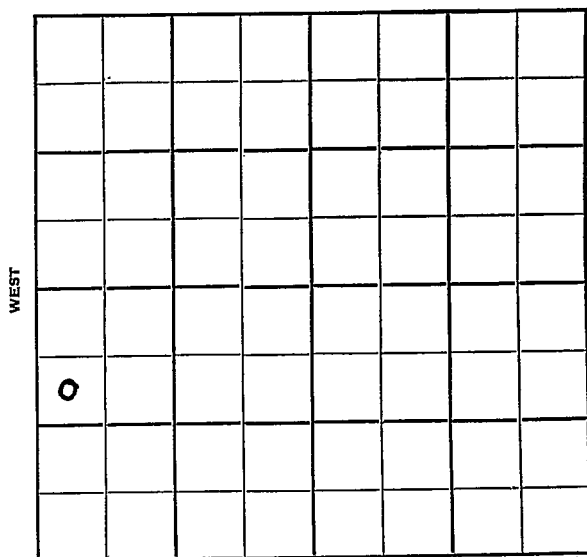

SOUTH

Rooks

KANSAS



Sec. 2 Twp. 10 R. 17 W

Well No. # 1 Loreg Farm

Anschutz, Flourney & Hastings Company

Flourney Contractor

Semi-Wildcat


990 Ft. from N. Line

 Ft. from S. Line

 Ft. from E. Line

330 Ft. from W. Line

SW NW SW

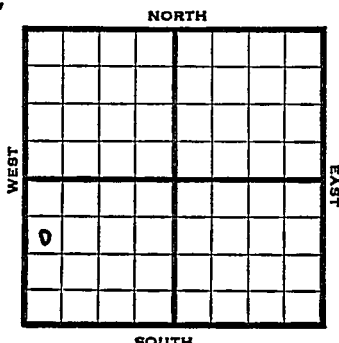

1952

Elev. 2034'

REPORT

5/28

Spud 5-26-52
8" @ 177 WOC

6/11

Spud 5-26-52
D & A TD 3502' 8" @ 177 Anhy 1280'
Heeb 3144' Tor. 3164' Lans. 3187'
DST 3211-29 open 40 min, rec 10' OCM
DST 3418-38 open 40 min, rec 50' oily
SW
Cong. 3457' Simp. dol. 3459'
Simp. sh. 3465' Arb. 3486'
TD 3502' D & A


ABANDONED



8" @ 177 WOC

J. G. McGEHEE

County Rooks State Kansas
 Sec. 2 (Blk. 10) (Sur. 17W) Map No.
 Operator Anschutz, Flourney & Hastin
 Well No. 1 Farm Loreg
 Elev. 2034 Location SW NW SW

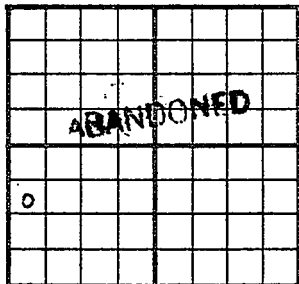

990 Ft. From N Line SW
330 Ft. From W Line Quarter

1st. Report

Completion JUN 11 1952

Remarks Semi Wildcat
Flourney - Contr.

Spudding Date 5-26-52

Drlg. Data D & A TD 3502

8" @ 177 Anhy 1280 Heeb. 3144

Tor. 3164 Lans. 3187 DST 3211-29

open 40 min. Rec. 10' ocm DST 3418-38

open 40 min. Rec. 50' oily sw

Cong. 3457 Simp. dol. 3459 Simp. sh.

3465 Arb. 3486 TD 3502

D & A

J. G. McGEHEE