


Section 2 Township 10 Range 20 WWell No. # 1 MarcotteCompany W. J. Coppinger

NORTH

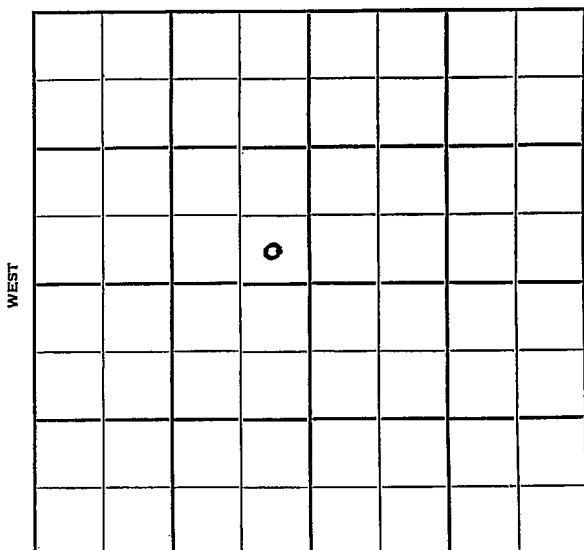

SOUTH

Rooks

KANSAS ✓

Sec. **2** Twp. **10** R. **20W**

Well No. **#1 Marcotte** Farm

W. J. Coppinger Company

Deek Contractor

Marcotte Pool

Ft. from N. Line


330 Ft. from S. Line

330 Ft. from E. Line

Ft. from W. Line

SE SE NW

Sunray FO

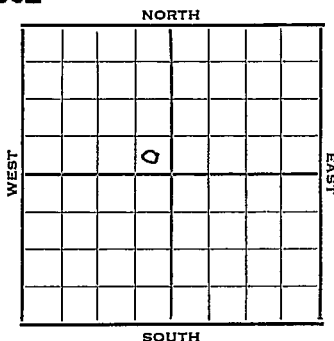

1952 Elev. **2247'** REPORT


7/30 Spud **77-25-52**
8" @ 215'
Anhy 1715'
Drlg. 2285'

8/6 Heeb. 3490 Tor. 3509
Douglas 3622 Lans. 3529
DST 3552-60, 1 hr. 12'm 990#
Drlg. 3600'

8/13 Spud **7-25-52**
D&A TD 3850' 8" @ 215'
Anhy 1715' Heeb. 3490
Tor. 3509 Doug 3522
Lans. 3529
DST 3552-60 open 1 hr. rec. 12'
mud, 990#
DST 3674-3742 open 1 hr. rec. 21'
mud 255# Cong. 3809
TD 3850' D&A

ABANDONED

County **Rooks** State **Kansas**
 Sec. **2** (Blk. Twp.) **10** (Sur. Rge.) **20W** Map No.
 Operator **W. J. Coppinger**
 Well No. **1** Farm **Marcotte**
 Elev. Location **SE SE NW**

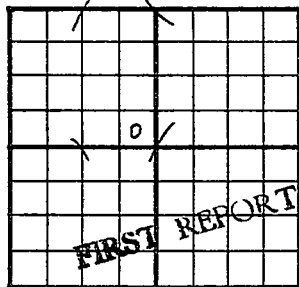

330 Ft. From **S** Line **NW**
330 Ft. From **E** Line **Quarter**

Ist. Report **JUL 30 1952**

Completion

Remarks **Sunray farmout**

Deek - Contr.

Spudding Date **7-25-52**


Drlg. Data

Marcotte Pool

8" @ 215 Anhy 1715 drlg. 2285

J. G. McGEHEE

County Rooks State Kansas
 Sec. 2 (Blk. 10) (Sur. 20W) Map No.
 Operator W. J. Coppinger
 Well No. 1 Farm Marcotte
 Elev. 2247 Location SESE NW

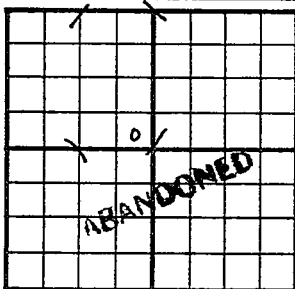

330 Ft. From S Line NW

330 Ft. From E Line Quarter

Ist. Report

Completion AUG 13 1952

Remarks Marcotte Pool

Deek - Contr.

Spudding Date 7-25-52

Drilg. Data D & A TD 3850

8" @ 215 Anhy1715 Heeb. 3490

Tor. 3509 Doug. 3522 Lans. 3529

DST 3552-60 open 1 hr. Rec. 12' mud

990# DST 3674-3742 open 1 hr.

Rec. 21' mud 255# Cong. 3809 TD 3850

D & A

J. G. McGEHEE