

Section 2 Township 10 Range 20W

Well No. #3 Sparks "B"

Company Barnett Oil

NORTH

WEST

EAST

SOUTH

14

Rooks

KANSAS

SEC.	TWP.	R.
2	10	20 W ✓

WELL NO.

3 Sparks "B"

FARM

COMPANY

Barnett Oil

CONTRACTOR

Barnett Drlg.

Marcotte Pool


Ft. from N. Line

1100 Ft. from S. Line

330 Ft. from E. Line

Ft. from W. Line

NE SE SW

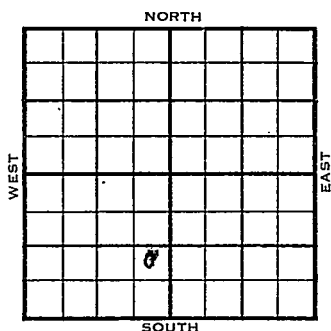


	ELEVATION	REPORT
1954	2243'	

1/6 Spud 12-31-53
8" @ 161' Anhy 1709'
Drlg. 2510'

1/13 Spud 12-31-53
D & A
TD 3851'
8" @ 161'
Anhy 1709', Heeb 3422', Lans 3510'
Gong 3772'
TD 3851'
D & A

ABANDONED

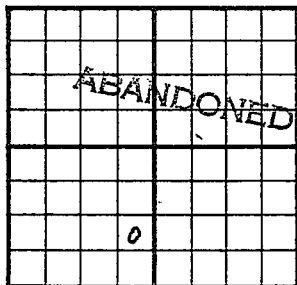County _____ Rooks _____ State KansasSec. 2 (Blk. Twp.) 10 (Sur. Rge.) 20W Map No. _____Operator Barnett OilWell No. 3 Farm Sparks "B"Elev. 2243 Location NE SE SW1100Ft. From S Line SW330Ft. From E Line Quarter1st. ReportCompletion JAN 13 1954Remarks Marcotte PoolBarnett Drlg. - Contr.Spudding Date 12-31-53Drlg. Data D & A TD 38518" @ 161 Anhy 1709 Heeb. 3422Lans. 3510 Cong. 3772 TD 3851D & A

J. G. McGEHEE