


DX 78-1

Section 2 Township 10 Range 20N

Well No. L Sparks "B"

Company Barnett Oil

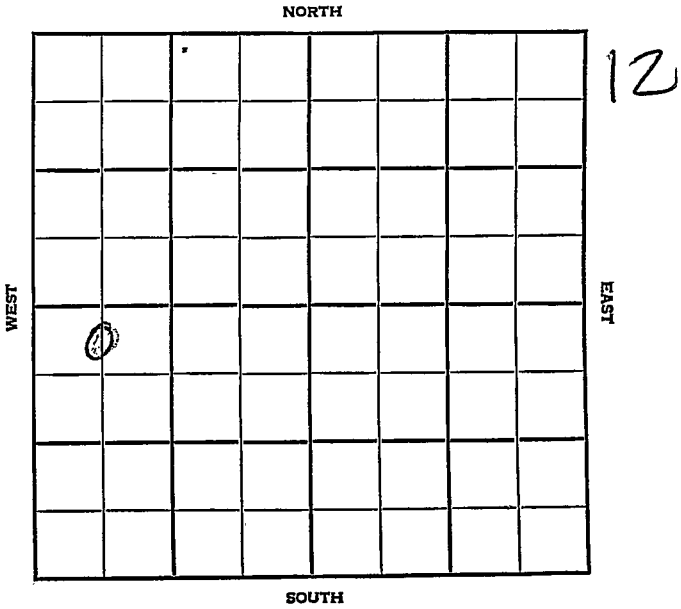

Rooks

KANSAS

SEC. 2	TWP. 19	R. 20W
-----------	------------	-----------

WELL NO. 4 Sparks "B" FARM

COMPANY Barnett Oil

CONTRACTOR Co. Tools


Marcotte

_____ Ft. from N. Line

_____ Ft. from S. Line

_____ Ft. from E. Line

_____ Ft. from W. Line

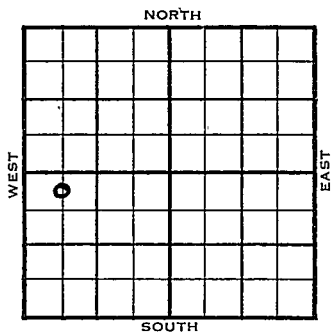

C N $\frac{1}{2}$ NW SW

1955	ELEVATION 2251'	REPORT
------	--------------------	--------

6/15

Comm 6-12-55
8" @ 172/125
Drlg 570

7/20

Comm 6-12-55
H 3489
L 3529
BKC 3742
C 3785
S 3814
A 3828
TD 3863
8" @ 172/125
5 1/2" @ 3862 CO to 3855
21/3841-48 S/6 boph 8 hr
Comp 149 bopd

COMPLETED

County Rooks Elev. _____
 Sec. 2 Twp. 10 Rge. 20W
 Company Barnett Oil
 FarmName Sparks "B" No. 4

TOPS	DEPTH	LOG	DATUM	Loc. in Sec.
Anh.				C $N\frac{1}{2}$ NW SW
TP.				
H.				
Tr.				
Dg.				
BL.				
L.				Geol. _____
K.C.				Contr. _____
B.K.C.				Co. tools _____
Ce.				Pool _____
C.				Marcotte _____
M.				
M.				
K.				
Mz.				
Me.				
V.				
S.				
S.				
A.				
R.				
PE.				
G.				
T.D.				

FIRST REPORT
 JUN 15 1955

Date Comm. 6-12-55
8" @ 172/125 drlg-570

Co.
Lse.
No.
Sec.
T.
R.

County Rooks Elev. 2251
 Sec. 2 Twp. 10 Rge. 20W
 Company Barnett Oil
 Farm Name Sparks "B" No. 4

TOPS	DEPTH	LOG	DATUM	Loc. in Sec.																												
Anh.				C N $\frac{1}{2}$ NW SW																												
TP.																																
H.	3489		1238																													
Tr.																																
Dg.				Geol.																												
Bl.																																
L.	3529		1278	Contr.																												
K.C.																																
B.K.C.	3742		1491	Co. tools																												
Ce.																																
C.	3785		1534	Pool																												
M.																																
M.				Marcotte																												
K.																																
Mz.				<table border="1"> <tr><td></td><td></td><td></td><td></td></tr> <tr><td></td><td></td><td></td><td></td></tr> <tr><td></td><td></td><td></td><td></td></tr> <tr><td></td><td></td><td></td><td></td></tr> <tr><td></td><td></td><td></td><td></td></tr> <tr><td></td><td></td><td></td><td></td></tr> <tr><td></td><td></td><td></td><td></td></tr> </table>																												
V.																																
S.	3814		1563																													
S.																																
A.	3828		1577																													
R.																																
PE.																																
G.	PF		1590-97																													
	S ₂		1611																													
T.D.	3863		1612																													

Date Comm. 6-12-55 JUL 20 1955

8" @ 172/125 5 $\frac{1}{2}$ " @ 3862 CO t.o 3855

21/ 3841-48 S/ 6 boph 8 hr.

Comp. 149 bopd

$$\begin{array}{r} 3863 \\ - 2251 \\ \hline 1612 \end{array}$$

$$\begin{array}{r} 3841 \\ - 2251 \\ \hline 1590 \end{array}$$