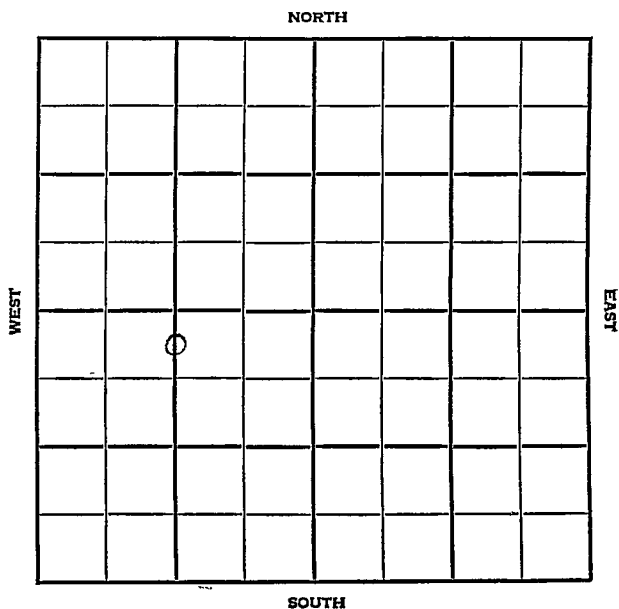


Section 2 Township 10 Range 20 WWell No. #5 Sparks "B"Company Barnett Oil

Rooks

WANSAS

SEC.	TWP.	R.
2	10	20W

WELL NO.

#5 Sparks "B"

FARM

COMPANY

Barnett Oil

CONTRACTOR

Co. Tools


Marcotte

_____ Ft. from N. Line

_____ Ft. from S. Line

_____ Ft. from E. Line

_____ Ft. from W. Line

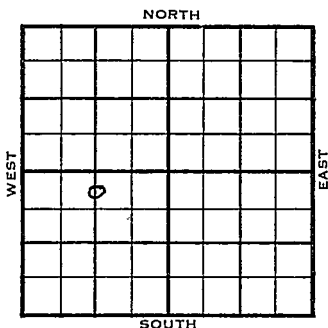N $\frac{1}{2}$ N $\frac{1}{2}$ SW

1955

ELEVATION

2250 KB

REPORT

8/31

Comm 8-24-55

Anh 1735

H 3485

L 3524

8" @ 146/150

Dr1g 3670

9/28

Comm 8-24-55

8" @ 146/150

Anh 1735

H 3485

L 3524

BKG 3742

C 3784

S 3829

A 3834

TD 3890

DST 3843-52 open 1 hr Rec 615' oil

345' hocomw 590/20" TD 3890

5 1/2" @ 3889 CO 24/3837-43

FU 1000' fluid 8 hr CO 12/3843/46

Comp 130 bopd

COMPLETED

County Rooks Elev. 2250 KB
 Sec. 2 Twp. 10 Rge. 20W
 Company Barnett Oil
 Farm Name Sparks "B" No. 5

TOPS	DEPTH	LOG	DATUM	Loc. in Sec.
Anh.	1735			N $\frac{1}{2}$ SW
Tr.				
H.	3485			
Tr.				
Dg.				
Bl.				
L.	3524			Geol.
K.C.				Contr.
B.K.C.				Co. tools
Ce.				Pool
C.				Marcotte
M.				FIRST REPORT AUG 31 55
M.				
K.				
Mz.				
Me.				
V.				
S.				
S.				
A.				
R.				
Pe.				
G.				
T.D.				

Date Comm. 8-24-558" @ 116/150 drlg. 3670

County Hooks Elev. 2250 KB
 Sec. 2 Twp. 10 Rge. 20W
 Company Barnett Oil
 Farm Name Sparks "B" No. 5

TOPS	DEPTH	LOG	DATUM	Loc. in Sec.
Anh.	<u>1735</u>			<u>C N$\frac{1}{2}$ N$\frac{1}{2}$ SW</u>
Top.				
H.	<u>3485</u>		<u>1235</u>	
Tr.				
Dg.				
BL.				
L.	<u>3524</u>		<u>1274</u>	Geol.
K.C.				
B.K.C.	<u>3742</u>		<u>1492</u>	Contr.
Ce.				
C.	<u>3784</u>		<u>1534</u>	Co. tools
M.				
M.				Pool
K.				
Mz.				<u>Marcotte</u>
Mq.				
V.				
S.	<u>3829</u>		<u>1579</u>	
S.				
A	<u>3834</u>		<u>1584</u>	
R.				
Pe.				
G.				
TD.	<u>3897</u>			

COMPLETE

Date Comm. 8-24-55 SEP 2 8 1955

8" @ 146/150 DST 3843-52 open 1 hr.

Rec. 615' oil 45' hocrmw 590/20"

TD 3890 5 $\frac{1}{2}$ " @ 3889 CO 24/ 3837-43

FU 1000' fluid 8 hr. CO 12/ 3843-46

Comp. 130 bopd