


KANSAS

Rooks

Section 2 Township 10 Range 20WWell No. 1 WilsonCompany Francis Oil & Gas et al

Wildcat

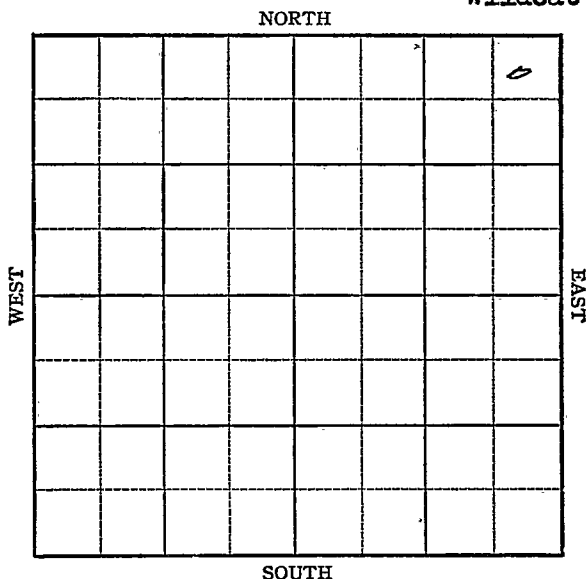


Sec. 2 Twp. 10 R. 20W ✓Well No. #1 Wilson FarmFrancis Oil & Gas et al Company

Wildcat

330' Ft. from N. Line Ft. from S. Line330' Ft. from E. Line Ft. from W. Line

NE/C

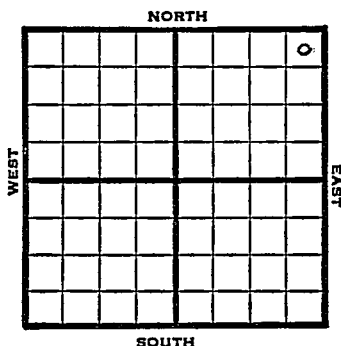

1949

Elev 2239' REPORT

3/16	Surface Hole
3/23	8" @ 216'
3/30	Lansing 3508'
	Drlg 3610'
4/6	Simpson 3802'
	Arb. 3823-25'
	TD 3825
	Run 5"
4/12	TD 3831'
	48 shots 3819-27
	GO
4/20	500 acid
	Swb $\frac{1}{2}$ bbls oil PH 9 hrs.
4/27	"
5/4	2000 acid
	Swb 9 bbls oil PH 4hrs.
5/10	"
5/18	"
5/25	"
6/1	"
6/7	"
6/15	Arb. 3823'
	5" @ 3822'
	TD 3841'
	2500 acid
	Pump 167 Oil $\neq$ 10% W Pot
	220 Gr.
	Comp

COMPLETED

Kansas


Map No. _____ Sec. 2 Twp. 10 R. 20WWell No. 1 Wilson

Francis Oil & Gas etal. _____ Company

FIRST REPORT _____ Contractor

NE/C

SECTION PLAT

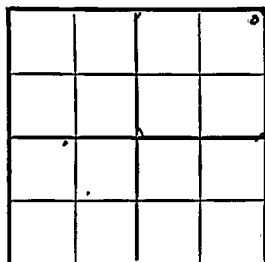330 Ft. from N. Line

_____ Ft. from S. Line

330 Ft. from E. Line

_____ Ft. from W. Line

Rooks County

RECORD

Location _____

Cased _____ in., _____ ft.

Rig up _____

Sand _____

Drilling and Remarks:

Gas _____

Oil _____

Total Depth _____

surface hole

PRODUCTION

1st 24 hrs. Nat. _____

1st 24 hrs. after shot _____

Gas _____ Cu. Ft.

Dry Hole _____

Abandoned _____

Date

MAR 16 1949

19

S. J. LEWIS

Scout

Rooks County Kansas State

Map No. K165 Sec. 2 Twp. 10 R. 20W

Well No. 1 Wilson

Francis Oil & Gas etal. Company

COMPLETE

Contractor

NE/C

E12239
SECTION PLAT

330 Ft. from N. Line

 Ft. from S. Line

330 Ft. from E. Line

 Ft. from W. Line

							0

Eveleigh Pool

Remarks:

CE 43823

5' 03822

ND 3841

2500 acid

Pump 167 oil + 10% W Sol

22 1/2 hr.

Date

Scout

JUN 15 1949