

O. W. D. D.

Rooks

KANSAS

Section 2 Township 10 Range 20WWell No. 31 - Wilson "A" SWDCompany Francis Oil & Gas

NORTH

					0		

SOUTH

7

WEST


EAST

Rooks

KANSAS ✓

Sec. 2 Twp. 10 R. 20WWell No. #3 Wilson "A" FarmFrancis Oil & Gas CompanyVeeder Contractor Ft. from N. Line330 Ft. from S. Line Ft. from E. Line990 Ft. from W. Line

SE SW NE

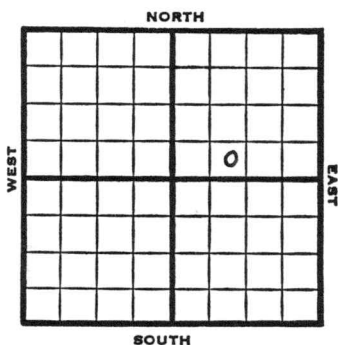

1953

Elev. 2230' REPORT

1/13

Location

1/22

8" @ 242 Anhy 1665'

Drlg. 3060'

1/29

NR

2/4

Spud 1-10-53 D & A TD 3837'

8" @ 242 Anhy 1665' Heeb 3478'

Tor. 3500' Lans. 3518' Marm. 3735'

Cong. 3796'

TD 3837' D & A

ABANDONED

County **Rooks** State **Kansas**

Sec. 2 (Blk. Twp.) 10 (Sur. Rge.) 20W Map No.

Operator Francis Oil & Gas

Well No. 3 Farm Wilson "A"

Elev.		Location	SE SW NE	
-------	--	----------	----------	--


330 Ft. From S Line NE

990 Ft. From W Line Quarter

1st. Report JAN 14 1953

Completion

Remarks

Veeder - Contr.


Spudding Date _____

Drlg. Data

Location

J. G. McGEHEE

County _____ Rocks _____ State Kansas
 Sec. 2 (Blk.) 10 (Sur. Rge.) 20W Map No. _____
 Operator Francis Oil & Gas
 Well No. 3 Farm Wilson "A"
 Elev. 2230 Location SE SW NE

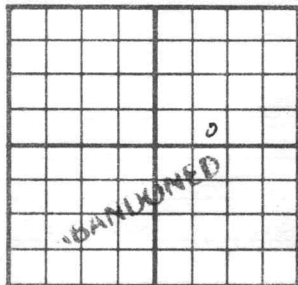

330 Ft. From S Line NE
990 Ft. From W Line Quarter

1st. Report

Completion FEB 4 1953

Remarks

Veeder - Contr.

Spudding Date 1-10-53

Drig. Data D & A TD 3837

8" @ 242 Anhy 1665 Heeb. 3478

Tor. 3500 Lans. 3518 Marm. 3735

Cong. 3796 TD 3837

D & A

Glick et al
O. W. D. DCO. Rooks ELEV. 2230SEC. 2 TWP. 10 RGE. 20WCOMPANY Francis Oil & GNO. 3

FIRST REPORT

OCT 30 '57

FARM Wilson "A" SWD

O. W. D. D.

LOC. SE SW NE

O. W. D. D.

GEOL. J.R. Green

CONTR. _____

POOL Marcotte

SPUD _____

Old Info. spud 1-10-53, 8" @ 242, Anhy.

1665, Heeb. 3478, Tor. 3500, Lans. 3518,

Marm. 3735, Ch Cong 3796, TD 3837 D&A,

New Info. Veeder Drlg. Tools Respud 10-22-53

Arb. 3872, Drlg. 4267.

CO.

LSE.

NO.

SEC.

TWP.

RGE.

