

Graham

KANSAS

Section 2 Township 10 Range 21 WWell No. # 7 McClellandCompany Jones, Shelburne & Famer

NORTH

WEST

						0	

EAST

SOUTH

Graham

KANSAS ✓

Sec. 2 Twp. 10 R. 21WWell No. #7 McClellan FarmJones, Shelburne & Farmer Company

Contractor

Cooper Pool


330 Ft. from N. Line

Ft. from S. Line

990 Ft. from E. Line

Ft. from W. Line

NW NE SE

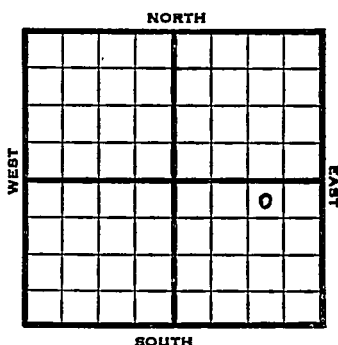

1952 Elev. 2286: REPORT

11/26 Location

12/4 Ø3495

12/11 Heeb 3484 Tor 3509 Lans 3523
Arb 3815-23 RTD 5" Ø3816 RUST12/18 DD 3829 1000A S/28 BOPH 1500' off
BTM POP

12/25 " " " " "

1/1 NR

1/8 NR

1/23 Spud 11-23-52
Oil Well
TD 3829
8" @ 141
Heeb 3484, Tor 3509, Lans 3523,
Arb. 3815
TD 3823,
5" @ 3816, DD 3829, 1000A
S/28 boph
Comp. 2120 bopd

COMPLETED

County **Graham** State **Kansas**
 Sec. **2** (Blk. **10** (Sur. **21W** Map No.
 (Twp.) (Rge.)
 Operator **Jones, Shelburne & Farmer**
 Well No. **7** Farm **McClellan**
 Elev. Location **NW NE SE**

330 Ft. From **N** Line **SE**
990 Ft. From **E** Line **Quarter**
 1st. Report **NOV 26 1952**
 Completion
 Remarks
 Spudding Date

Drlg. Data

Cooper Pool**Location****J. G. McGEHEE**

County Graham State Kansas
 Sec. 2 (Blk. 10 (Sur. 21W Map No.
 (Twp.) (Rge.)
 Operator Jones, Shelburne & Farmer
 Well No. 7 Farm McClellan
 Elev. 2286 Location NW NE SE

330 Ft. From N Line SE

990 Ft. From E Line Quarter

1st. Report

Completion JAN 23 1953Remarks Cooper PoolSpudding Date 11-23-52Drlg. Data Oil well TD 38298" @ 141 Heeb. 3484 Tor. 3509Lans. 3523 Arb. 3815 TD 38235" @ 3816 DD 3829 1000 A S/ 28 bophComp. 2120 bopd

J. G. McGEHEE