


Section 2 Township 10 Range 21WWell No. #2 McClellanCompany Jones, Shelborne & Farmer

NORTH

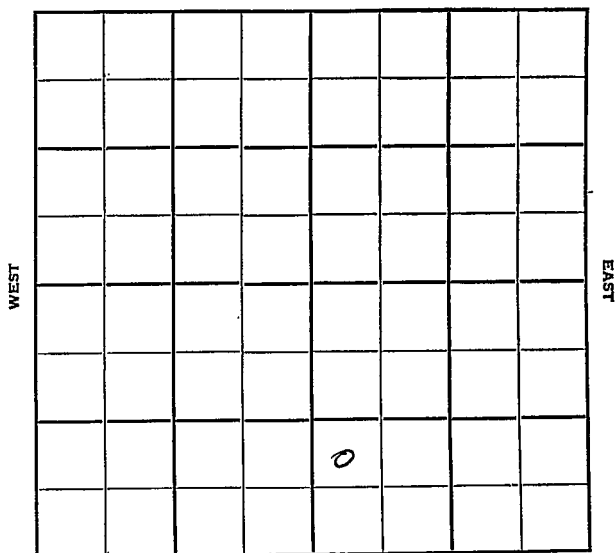

SOUTH

Graham
10

KANSAS
21W

Sec. 2 Twp. 10 R. 21W

Well No. #2 McClellan Farm

Jones, Shelborne & Farmer Company

Cooper Pool


 Ft. from N. Line

990' Ft. from S. Line

 Ft. from E. Line

330' Ft. from W. Line

NW SW SE

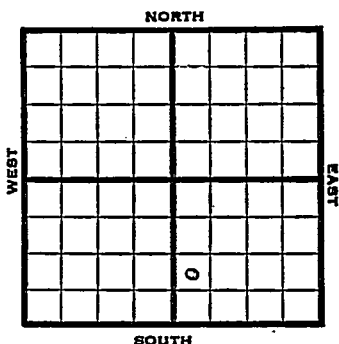

1951

Elev. 2246' REPORT

2/7

Location

3/28

Spud 2-8-51

Oil well TD 3810'

8" @ 168', Anhy 1715', Heeb. 3453',

Lans. 3501', Arb. 3789',

DST 3789-3805' open 1 hr. Rec. 100'

OCM, TD 3810', 5" @ 3805'

B/ 2½ boph 500 A S/ 15 boph

Comp. 243 bopd 27 gr.

COMPLETED



Operator Jones, Shelborne & Farmer

Well No. 2 Farm McClellan

Elev.	Location	NW	SW	SE
-------	----------	----	----	----

FIRST REPORT	
	0

990 Ft. From S Line SE

330 Ft. From **W** Line Quarter1st. Report FFA 7 1951

Completion

Remarks	Ohio farmout
---------	--------------

Spudding Date

Drlq. Data Cooper Pool

Location

J. E. TYRA

J. E. TYRA